

KANSAS


Form 51-5M-7-40-Palace

Rice

Section 20 Township 20 Range 10-W

Well No. #1 Rose

Company Vickers

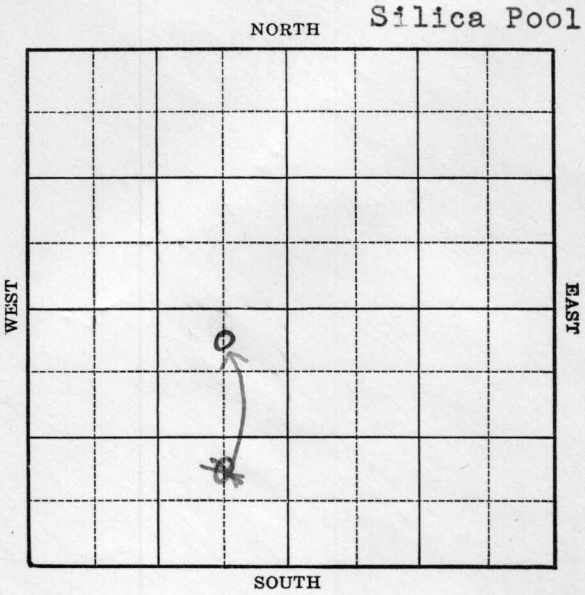

Sec. 20 Twp. 20 R. 10-W

Well No. #1 Rose Farm _____
Vickers Company _____


(Silica)

330 Ft. from N. Line

~~990~~ Ft. from S. Line

660 Ft. from E. Line

_____ Ft. from W. Line

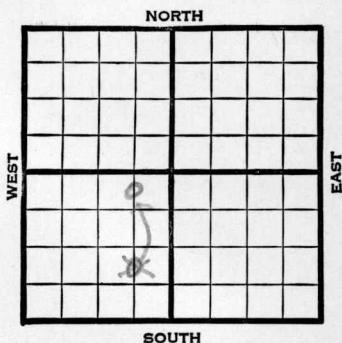

1940	REPORT
9/18	Derrick.
9/26	10" - 157' WOC.
10/3	Drlg. 29 49'
10/10	7" - 3297' Simp. 3282' Arb. 3297' T.D. 3000' S.O. RUST.
10/17	T.D. 3399½' 300' oil 3 hours. 2000 acid.
10/23	Arb. 3295' 7" - 3295' T.D. 3300' 2000 acid.
	Depthograph 1057 bbls. plus 15% water.
	COMPLETED

Map No. 46 Sec. 20 Twp. 20 R. 10W

Well No. 1 Rose

Vickers Company

Contractor

FIRST REPORT

C N L NE SW

_____ Ft. from N. Line

990 Ft. from S. Line

660 Ft. from E. Line

_____ Ft. from W. Line

SECTION PLAT

SILICA POOL

Location _____

Rig up _____

Drilling and Remarks:

Derrick

RECORD

Cased _____ in., _____ ft.

Sand _____

Gas _____

Oil _____

Total Depth _____

PRODUCTION

1st 24 hrs. Nat. _____

1st 24 hrs. after shot _____

Gas _____ Cu. Ft.

Dry Hole _____

Abandoned _____

Date

SEP 18 1940 19

S. J. LEWIS Scout

Map No. 46 Sec. 20 Twp. 20 R. 10W

Well No. 1 Rose

Vickers Petroleum Company

CORRECTION Contractor

SECTION PLAT

C N L NE SW

330 Ft. from N. Line

_____ Ft. from S. Line

660 Ft. from E. Line

_____ Ft. from W. Line

	o		

SILICA POOL

Location _____

Rig up _____

Drilling and Remarks:

Reported

990 x 660

RECORD

Cased _____ in., _____ ft.

Sand _____

Gas _____

Oil _____

Total Depth _____

PRODUCTION

1st 24 hrs. Nat. _____

1st 24 hrs. after shot _____

Gas _____ Cu. Ft.

Dry Hole _____

Abandoned _____

Date

OCT 28 1940 19

S. J. LEWIS Scout

Map No. 46 Sec. 20 Twp. 20 R. 10W

Well No. 1 Rose

Vickers Petroleum Company

Contractor

COMPLETED

C N L NE SW

SECTION PLAT

330 Ft. from N. Line

_____ Ft. from S. Line

660 Ft. from E. Line

_____ Ft. from W. Line

	0		

SILICA POOL

Location _____

Rig up _____

Drilling and Remarks:

Art 8295
7" @ 3295
2000 and
Depth 1057 + 15%
Water 88

RECORD

Cased _____ in., _____ ft.

Sand _____

Gas _____

Oil _____

Total Depth 3300

PRODUCTION

1st 24 hrs. Nat. _____

1st 24 hrs. after shot _____

Gas _____ Cu. Ft.

Dry Hole _____

Abandoned _____

Date

OCT 23 1940

S. J. LEWIS Scout