


Section 28 Township 31 Range 4-E

Well No. 1 Waite

Company McKnab & B. B. Blair

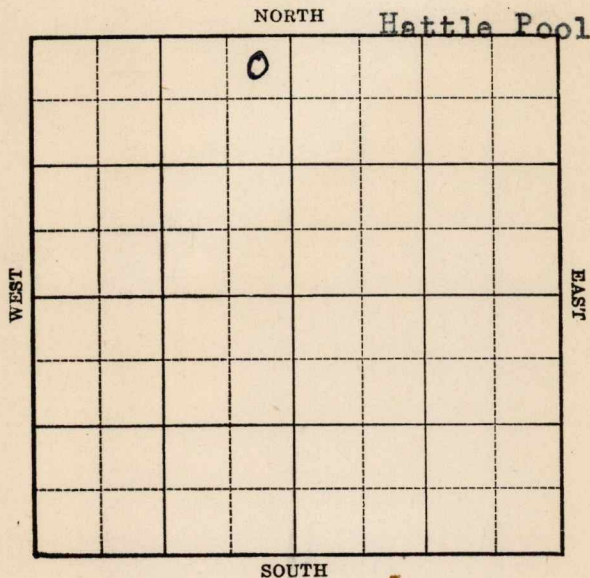

Cowley

KANSAS

Map No. 2 Sec. 28 Twp. 31 R. 4EWell No. 1 WaiteMcKnab & B.B. Blair

Company

~~FIRST REPORT~~

Contractor

NE NW

330 Ft. from N. Line Ft. from S. Line330 Ft. from E. Line Ft. from W. Line

SECTION PLAT

	0		

HITTLE POOL

Location Rig up

Drilling and Remarks:

10" @ 100Dr lg. 550

RECORD

Cased in., ft.Sand Gas Oil Total Depth

PRODUCTION

1st 24 hrs. Nat. 1st 24 hrs. after shot Gas Cu. Ft.Dry Hole Abandoned

Date

MAY 10 1939

19

S. J. LEWIS

Scout

KANSAS

Cowley

Map No. 2 Sec. 28 Twp. 31 R. 4EWell No. 1 WaiteMcKnab & B. B. Blair Company

Contractor

COMPLETED

NE NW

SECTION PLAT

330 Ft. from N. Line Ft. from S. Line330 Ft. from E. Line Ft. from W. Line

HITTLE POOL

Location

RECORD

Cased in., ft.Rig up Sand

Drilling and Remarks:

Gas *Ar 83339*Oil *7" C 3326*Total Depth 3350

PRODUCTION

*Ar 6528 flow*1st 24 hrs. Nat. 1st 24 hrs. after shot Gas Cu. Ft.Dry Hole Abandoned

Date

JUN 14 1939

19

S. J. LEWIS

Scout