

KANSAS


Form 51—5M—7-39—Palace

Rice

Section 20 Township 20 Range 10-W

Well No. #3 Scott

Company Atlantic Production

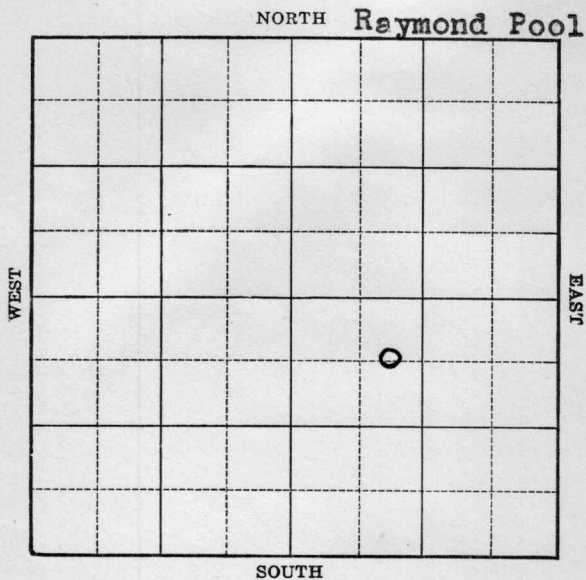

KANSAS

Rice


Sec. 20 Twp. 20 R. 10-WWell No. #3 Scott FarmAtlantic Prod.

Company

(Raymond)

660 Ft. from N. Line Ft. from S. Line Ft. from E. Line990 Ft. from W. Line

Elev. 1742

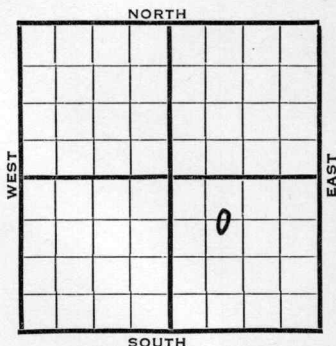

REPORT

1940

6/5 Rig on Ground.

6/13 10" - 260' Anhy 420'

Drlg. 1440'

6/20 Lans. 2994' Arb. 3297'

7" - 3297' T.D. 3302' RUST.

6/27 2550' oil at 3302'

7/3 1000 acid.

7/10 Arb. 3297'

7" - 3297'

T.D. 3302'

1000 acid.

Pump 412 oil plus 4% water.

COMPLETED

Map No. 46 Sec. 20 Twp. 20 R. 10WWell No. 3 ScottAtlantic Production

Company

Contractor

FIRST REPORT

SECTION PLAT

C E L NW SE

660 Ft. from N. Line

Ft. from S. Line

Ft. from E. Line

990 Ft. from W. Line

RAYMOND POOL

		o	

Location

Rig up

Drilling and Remarks:

Rig on Ground

RECORD

Cased _____ in., _____ ft.

Sand _____

Gas _____

Oil _____

Total Depth _____

PRODUCTION

1st 24 hrs. Nat. _____

1st 24 hrs. after shot _____

Gas _____ Cu. Ft.

Dry Hole _____

Abandoned _____

Date

JUN 5 1940

S. J. LEWIS

Scout

Map No. _____ Sec. 20 Twp. 20 R. 10WWell No. 3 Scott

_____ Atlantic Production _____ Company

COMPLETED

_____ Contractor

C E L NW SE

SECTION PLAT

660 Ft. from N. Line

_____ Ft. from S. Line

_____ Ft. from E. Line

990 Ft. from W. Line**RAYMOND POOL**

Location _____

Rig up _____

Drilling and Remarks:

*CR # 3297**7" @ 3297**1000 acd**Pump 412 oil**+ 4% Water***RECORD**

Cased _____ in., _____ ft.

Sand _____

Gas _____

Oil _____

Total Depth 3302**PRODUCTION**

1st 24 hrs. Nat. _____

1st 24 hrs. after shot _____

Gas _____ Cu. Ft.

Dry Hole _____

Abandoned _____

Date

JUL 10 1940 19S. J. LEWIS Scout