

KANSAS


Form 51—5M—7-39—Palace

Cowley

Section 28 Township 31- Range 4-E

Well No. #4 Waite

Company McKnab & Blair

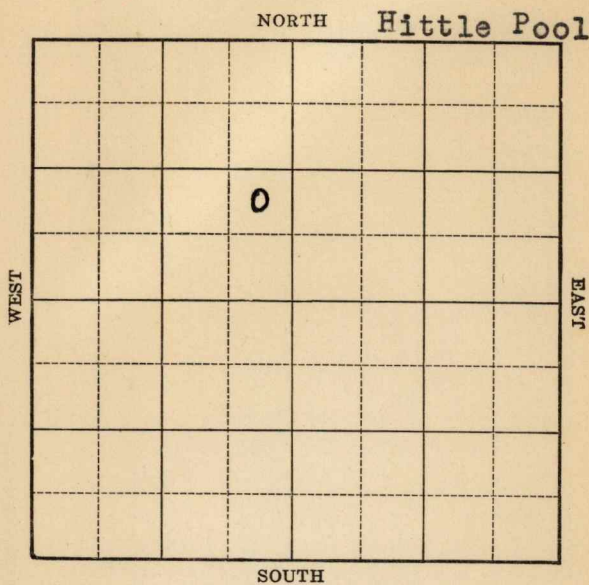

Cowley

Map No. 2 Sec. 28 Twp. 31 R. 4EWell No. 4 WaiteMcKnab & Blair Company

Contractor

FIRST REPORT

NE SE NW

SECTION PLAT

 Ft. from N. Line990 Ft. from S. Line330 Ft. from E. Line Ft. from W. Line

HITTLE POOL

Location Rig up

Drilling and Remarks:

10" - 111Dr 1 g. 1900

RECORD

Cased in., ft.Sand Gas Oil Total Depth

PRODUCTION

1st 24 hrs. Nat. 1st 24 hrs. after shot Gas Cu. Ft.Dry Hole Abandoned

Date

SEP 6 1939

19

S. J. LEWIS Scout

Cowley

KANSAS

Map No. 2 Sec. 28 Twp. 31 R. 4EWell No. 4 Waite

McKnab & Blair

Company

Contractor

COMPLETED

NE SE NW

Ft. from N. Line

990 Ft. from S. Line

330 Ft. from E. Line

Ft. from W. Line

SECTION PLAT

	0		

HITTLE POOL

Location

RECORD

Cased _____ in., _____ ft.

Sand _____

Gas _____

Oil _____

Total Depth 3335

PRODUCTION

1st 24 hrs. Nat. _____

1st 24 hrs. after shot _____

Gas _____ Cu. Ft.

Dry Hole _____

Abandoned _____

Rig up

Drilling and Remarks:

*Oil 3324**7" @ 3310**Flow Po 8**7891*

Date

SEP 27 1939

S. J. LEWIS

Scout