

KANSAS


Rice

Form 51—5M—7-40—Palace

Section 20 Township 20 Range 10-W

Well No. #4 Scott

Company Atlantic Prod.

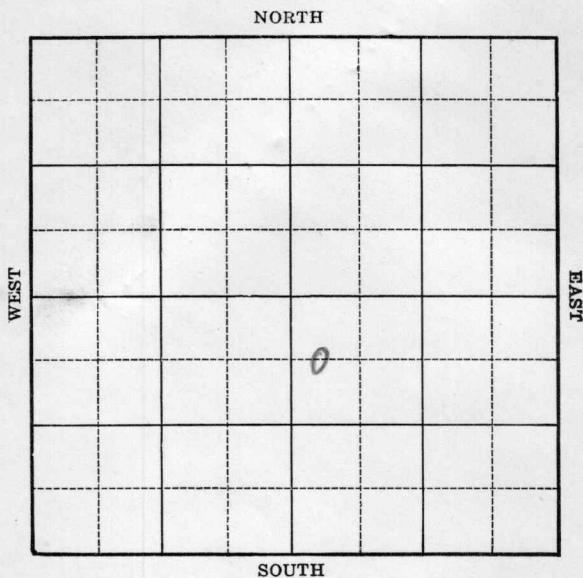


Sec. 20 Twp. 20 R. 10-WWell No. #4 Scott FarmAtlantic Production Company

(Raymond)

660 Ft. from N. Line Ft. from S. Line Ft. from E. Line330 Ft. from W. Line

Elev. 1740

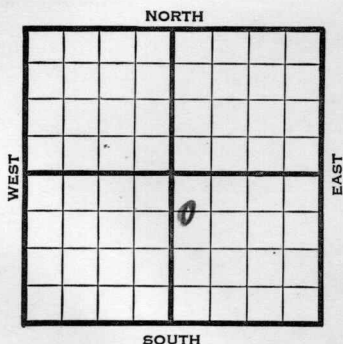

1940

REPORT

12/11

Location

12/26

8" - 277' Drlg. 2440'

1941

1/2

Topeka 2600' Lans. 3010'

Cong. 3263' Simp. 3287'

Arb. 3301-04' T.D. 5" - 3301'

S.O. RUST.

1/8

Arb. 3301'

5" - 3301'

T.D. 3304'

250 acid.

Potential 148 bbls., pump.

42.5 Gravity

COMPLETED

Map No. 46 Sec. 20 Twp. 20 R. 10WWell No. 4 ScottAtlantic Production CompanyContractor**FIRST REPORT**

C W L NW SW

660 Ft. from N. Line Ft. from S. Line Ft. from E. Line330 Ft. from W. Line

RAYMOND POOL

SECTION PLAT

o		o	

Location XRig up

Drilling and Remarks:


RECORDCased in., ft.Sand Gas Oil Total Depth **PRODUCTION**1st 24 hrs. Nat. 1st 24 hrs. after shot Gas Cu. Ft.Dry Hole Abandoned

Date

DEC 11 1940 19S. J. LEWIS Scout

Sam - Believe this loc. to be in SE 1/4.

Pattman

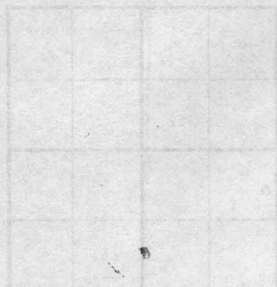

Misc. Small Maps	RAM
Cards	RAM
Tracing	RAM
France Map	RAM
Seaborough Map	RAM
Moody Map	RAM
Geological Dept.	RAM
Moody Flat Book	RAM

Map No. 46 Sec. 20 Twp. 20 R. 10WWell No. 4 Scott

Atlantic Production

Company

CORRECTION

Contractor

SECTION PLAT

		o	

C W L NW SE

660 Ft. from N. Line

Ft. from S. Line

Ft. from E. Line

330 Ft. from W. Line

RAYMOND POOL

Location _____

Rig up _____

Drilling and Remarks:

Reported

C W L NW SW

RECORD

Cased _____ in., _____ ft.

Sand _____

Gas _____

Oil _____

Total Depth _____

PRODUCTION

1st 24 hrs. Nat. _____

1st 24 hrs. after shot _____

Gas _____ Cu. Ft.

Dry Hole _____

Abandoned _____

Date

DEC 23 1940 19

S. J. LEWIS

Scout

Map No. 46 Sec. 20 Twp. 20 R. 10WWell No. 4 ScottAtlantic Production Company

Contractor

COMPLETED**SECTION PLAT**

C W L NW SE

		o	

660 Ft. from N. Line Ft. from S. Line Ft. from E. Line330 Ft. from W. Line

RAYMOND POOL

Location Rig up

Drilling and Remarks:

*Cr 83301**5" @ 3301**250 acd**Pump 148 P & X**42.5 Gr.***RECORD**Cased in., ft.Sand Gas Oil Total Depth 3304**PRODUCTION**1st 24 hrs. Nat. 1st 24 hrs. after shot Gas Cu. Ft.Dry Hole Abandoned

Date

JAN 8 1941

S. J. LEWIS Scout