

KANSAS

Rice

Form 51—5M—7-40—Palace


Section 20 Township 20 Range 10-W

Well No. #2 Scott "A"

Company Vickers

Raymond Pool

NORTH

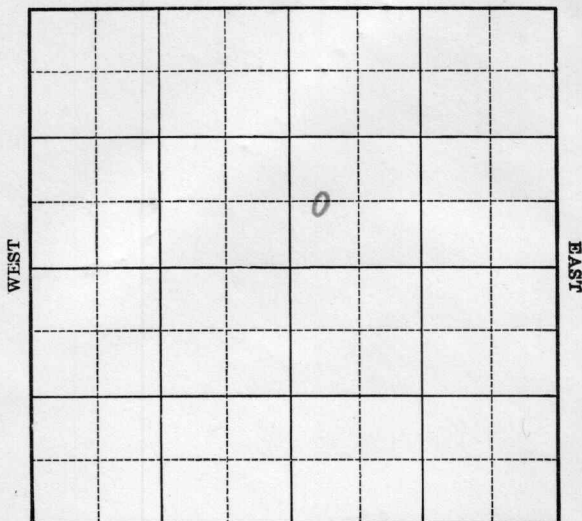

SOUTH

Map No. 46 Sec. 20 Twp. 20 R. 10WWell No. 2 Scott "A"Vickers

Company

FIRST REPORT

Contractor

SECTION PLAT

		o	

C W L SW NE

Ft. from N. Line

660 Ft. from S. Line

Ft. from E. Line

330 Ft. from W. Line

RAYMOND POOL

Location _____

Rig up _____

Drilling and Remarks:

S.H.

RECORD

Cased _____ in., _____ ft.

Sand _____

Gas _____

Oil _____

Total Depth _____

PRODUCTION

1st 24 hrs. Nat. _____

1st 24 hrs. after shot _____

Gas _____ Cu. Ft.

Dry Hole _____

Abandoned _____

Date

JAN 29 1941 19 _____ S. J. LEWIS Scout

Map No. _____ Sec. 20 Twp. 20 R. 10W

Well No. 2 Scott "A"

Vickers _____ Company

COMPLETED

Contractor

SECTION PLAT

C W L SW NE

_____ Ft. from N. Line

660 _____ Ft. from S. Line

_____ Ft. from E. Line

330 _____ Ft. from W. Line

RAYMOND POOL

Location _____

Rig up _____

Drilling and Remarks:

*Ar 8299**5" @ 3300**2000 acid**Pump 47 P & S**+ 10% Water**42.5 Gr*

RECORD

Cased _____ in., _____ ft.

Sand _____

Gas _____

Oil _____

Total Depth *3302 1/2*

PRODUCTION

1st 24 hrs. Nat. _____

1st 24 hrs. after shot _____

Gas _____ Cu. Ft.

Dry Hole _____

Abandoned _____

Date

FEB 19 1941

19

S. J. LEWIS

Scout