


Map No. KANSAS Sec. 70 Twp. 70 R. 10<sup>w</sup>

Well No. F. Specht Farm  
Sinclair - Prairie Company

NORTH

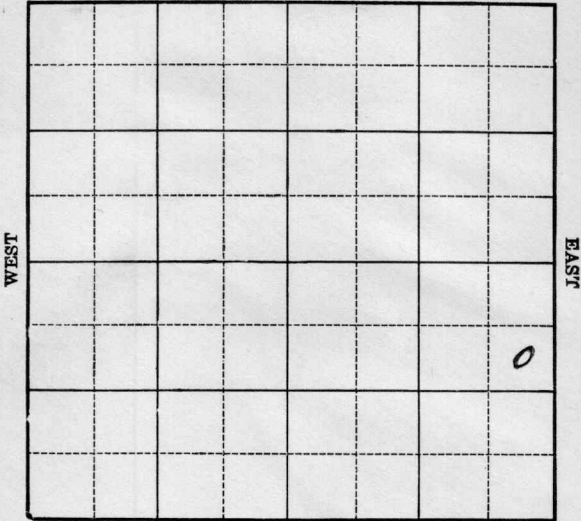

SOUTH

Location \_\_\_\_\_  
Drilling Remarks \_\_\_\_\_

Rig Up \_\_\_\_\_  
Drilling Remarks \_\_\_\_\_

\_\_\_\_\_  
\_\_\_\_\_  
**RECORD**

**PRODUCTION**

Cased \_\_\_\_\_ in. \_\_\_\_\_ ft.  
Sand \_\_\_\_\_  
Gas \_\_\_\_\_  
Oil \_\_\_\_\_  
Total Depth \_\_\_\_\_


1st 24 hrs. Nat. \_\_\_\_\_  
1st 24 hrs. after shot \_\_\_\_\_  
Gas \_\_\_\_\_ cu. ft. \_\_\_\_\_  
Dry Hole \_\_\_\_\_  
Abandoned \_\_\_\_\_

Rice

Map No. KANSAS Sec. 70 Twp. 70 R. 10<sup>W</sup>

Well No. 7 Specht Farm  
Sinclair - Prairie Company

990 Ft. from N. Line  
         Ft. from S. Line  
330 Ft. from E. Line  
         Ft. from W. Line

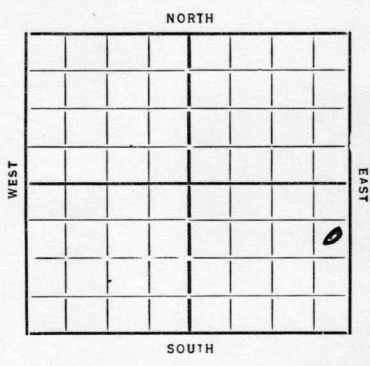

Date 1935 REPORT

1/16 Bldg Rot.  
1/24 Rig  
1/31 Bly 525 12" 126  
2/7 " 7194  
2/14 " 7962  
2/21 7" 3291 Rust  
2/28 Sil 3290 s.w. 3295  
PB 3294 Est 50 Bbls.  
3/6 Siliceous 3290 T 17 3295  
PB 3294 1000 acid  
403 Bbls.

COMPLETED

Map No. 46 Sec. 20 Twp. 20 R. 10W

Well No. 2-Speekt

Smilan-prairie Company

Contractor

FIRST REPORTS

SECTION PLAT

990 Ft. from N. Line

..... Ft. from S. Line

330 Ft. from E. Line

..... Ft. from W. Line

			0

Location.....

Rig up.....

Drilling and Remarks:

Blkg Rot

RECORD

Cased..... in., ..... ft.

Sand.....

Gas.....

Oil.....

Total Depth.....

PRODUCTION

1st 24 hrs. Nat.....

1st 24 hrs. after shot.....

Gas..... Cu. Ft.

Dry Hole.....

Abandoned.....

Date

ORVAL MANNSCHECK

1-16-37 192..... Scout

Map No. 46 Sec. 20 Twp. 20 R. 10W

Well No. 2-Specht

Sinclair prairie Company

Contractor

COMPLETED

SECTION PLAT

990 Ft. from N. Line

..... Ft. from S. Line

330 Ft. from E. Line

..... Ft. from W. Line

			0

Location.....

Rig up.....

Drilling and Remarks:

P. B. 3294  
1000 and  
403 ft

RECORD

Cased..... in., ..... ft.

Sand silts 3290

Gas.....

Oil.....

Total Depth 3295

PRODUCTION

1st 24 hrs. Nat.....

1st 24 hrs. after shot.....

Gas..... Cu. Ft.

Dry Hole.....

Abandoned.....

Date

3-6-35 192.....

ORVAL MANNSCHRECK

Scout