


O. W. D. D.

Section 21 Township 20 Range 10 WWell No. # 1 MezgerCompany Pabco
~~Ben Hyde~~

NORTH

WEST

EAST

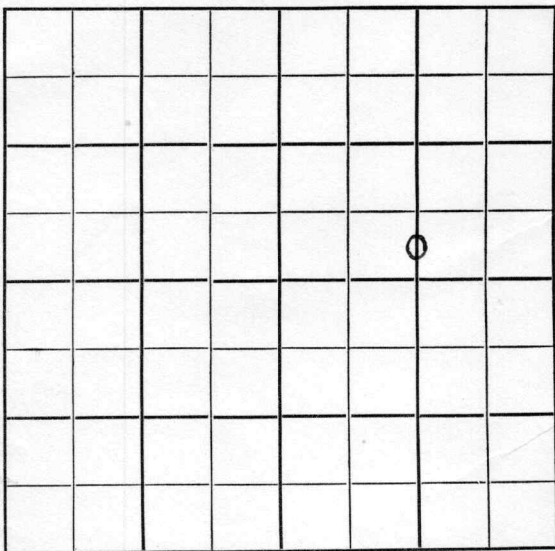

SOUTH

O.W.D.D

Rice KANSAS

Sec. 21 Twp. 20 R. 10 WWell No. # 1 Mezger FarmPabco
Ben Hyde


Company

Isern

Contractor

Raymond Ft. from N. Line330 Ft. from S. Line1320 Ft. from E. Line Ft. from W. Line

S/2 S/2 NE

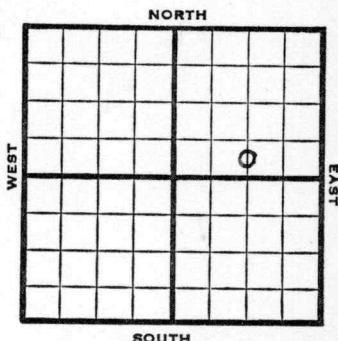

1952

Elev. 1793' REPORT

1/16
1/23

RUR
Spud 1-15-52
D&A TD 2573
8" @ 168
Sand 2568
DST 2548-73 opn 45 min.
Rec. 390' gcm SSO
D&A

ABANDONED

1952
9/17


O.W.D.D

OTD 2573
Topeka 2592 Heeb. 2868
Br L 2997 Lans. 3021
DST 3102-29 1 hr. 60 sgcm circu
@ 3294

9/24
10/1

D&A
D&A TD 3367 OTD 2573
Top. 2592 Heeb. 2868
Br Li 2997 Lans. 3021
DST 3102-29 open 1 hr. rec. 60'
SGCM Arb. 3340 TD 3367
D&A

ABANDONED

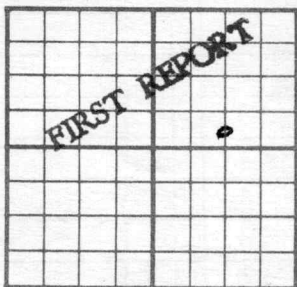County **Rice** State **Kansas**Sec. **21** (Blk. Twp.) **20** (Sur. Rge.) **10W** Map No.Operator **Ben Hyde**Well No. **1** Farm **Mezger**Elev. Location **S/2 S/2 NE****330** Ft. From **S** Line **NE****1320** Ft. From **E** Line Quarter1st. Report **JAN 16 1952**


Completion

Remarks

Isern - Contr.

Spudding Date


Drlg. Data **Raymond****RUR****J. E. TYRA**

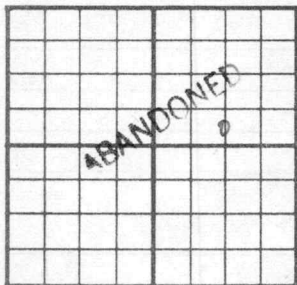County Rice State KansasSec. 21 (Blk.
Twp.) 20 (Sur.
Rge.) 10W Map No.Operator Ben HydeWell No. 1 Farm MezgerElev. 1793 Location C S L S $\frac{1}{2}$ NE330 Ft. From S Line NE1320 Ft. From E Line Quarter

1st. Report

Completion JAN 23 1952Remarks Raymond PoolIsern Drlg. - Contr.Spudding Date 1-15-52Drlg. Data D & A TD 25738" @ 168 Sand 2568 DST 2548-73open 45 min. Rec. 390' gcm SSOD & A

County Rice State Kansas
 Sec. 21 (Blk. Twp.) 20 (Sur. Rge.) 10W Map No.
 Operator Pabco
 Well No. 1 Farm Mezger
 Elev. _____ Location C S/2 S/2 NE

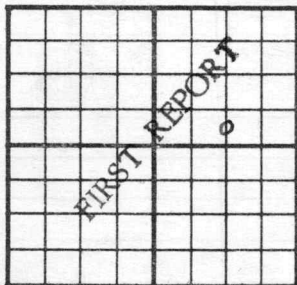

530 Ft. From S Line NE
1320 Ft. From E Line Quarter

1st. Report SEP 17 1952

Completion _____


Remarks OWDD

Spudding Date _____

Drlg. Data

OTD 2573 Topeka 2592 Heeb 2868 BrL 2997
Lans 3021 DST 3102-29 lhr. 60-sgem circu
@ 3294

J. G. McGEHLE

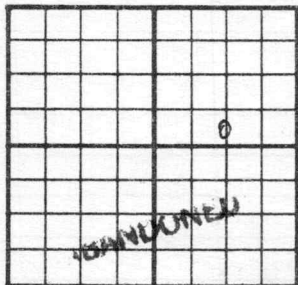County Rice State KansasSec. 21 (Blk.
Twps.) 20 (Sur.
Rge.) 10W Map No.Operator Pabco Drlg.Well No. 1 Farm MezgerElev. 1793 Location C S $\frac{1}{2}$ S $\frac{1}{2}$ NE330 Ft. From S Line NE1320 Ft. From E Line Quarter

1st. Report

Completion OCT 1 1952Remarks OWDD

Spudding Date

Drlg. Data D & A TD 3367OTD 2573 Topl 2592 Heeb. 2868Br. line 2997 Lans. 3021 DST 3102-29open 1 hr. Rec. 60' sgcm Arb. 3340TD 3367D & A