


Map No. KANSAS Sec. 21 Twp. 20 R. 10<sup>w</sup>  
Well No. 1 - Mezger Farm  
Independent Oil & Gas Company

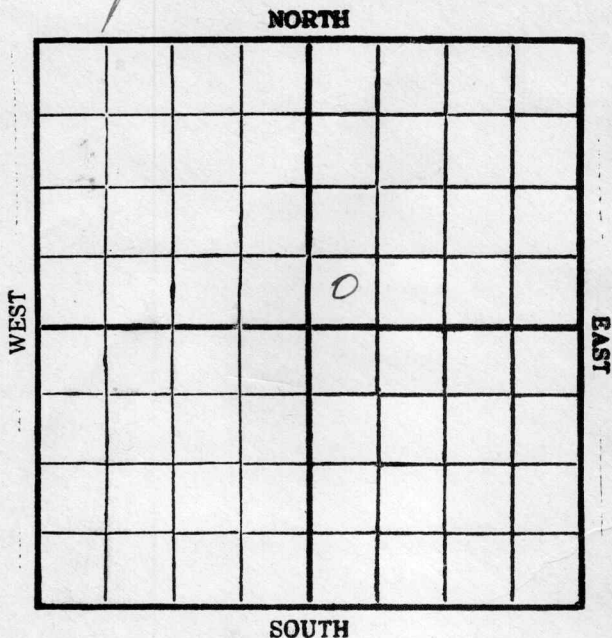

Location \_\_\_\_\_  
Drilling Remarks \_\_\_\_\_  
\_\_\_\_\_  
\_\_\_\_\_  
Rig Up \_\_\_\_\_  
Drilling Remarks \_\_\_\_\_  
\_\_\_\_\_  
\_\_\_\_\_  
**RECORD**


Cased \_\_\_\_\_ in. \_\_\_\_\_ ft.  
Sand \_\_\_\_\_  
Gas \_\_\_\_\_  
Oil \_\_\_\_\_  
Total Depth \_\_\_\_\_

**PRODUCTION**

1st 24 hrs. Nat. \_\_\_\_\_  
1st 24 hrs. after shot \_\_\_\_\_  
Gas \_\_\_\_\_ cu. ft. \_\_\_\_\_  
Dry Hole \_\_\_\_\_  
Abandoned \_\_\_\_\_

Map No. KANSAS Sec. 21 Twp. 20 R. 10<sup>w</sup>  
 Well No. 1- Mezger Farm  
Independent Oil & Gas Company

NORTH

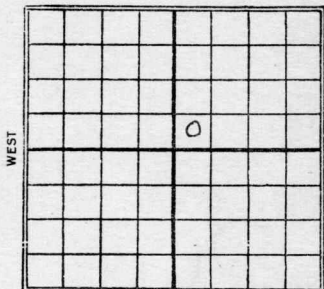

Ft. from N. Line

330 Ft. from S. Line

Ft. from E. Line

330 Ft. from W. Line

SOUTH

Date 1929 REPORT

|       |                           |
|-------|---------------------------|
| 10/16 | Location                  |
| 10/23 |                           |
| 10/30 |                           |
| 11/6  | Run up                    |
| 11/13 | 119170                    |
| 11/20 | " 770                     |
| 11/27 | " 1370                    |
| 12/4  | " 1730                    |
| 12/11 | " 1930                    |
| 12/18 | " 2000'                   |
| 12/23 | " 2125'                   |
| 12/30 | " 2440'                   |
| 1930  |                           |
| 1/8   | " 2725'                   |
| 1/15  | " 2955'                   |
| 1/22  | Show oil 3085'            |
| 1/31  | Only 3182' 6"-3115' 3224' |
|       | Top Pay 3296'             |
|       | small show                |
|       | 17FW at 3298'             |
| 2/5   | Only 3315'                |

- 2/10- Lem 6" 3316'
- 2/14- Top sdylime 3329-32  
T.D. 3332' - Haul  
1500' oil in 3 hrs  
No water
- 2/15- T.D. 3332' swab  
496 bbl 24 hr  
2 ft cavings in hole
- 2/19- Tap Pay 3327 oil  
3330-32. Swabbed  
496 bbls 1<sup>st</sup> 24 hrs.
- 2/21- T.D. 3339' swab  
288 bbl oil 6 hrs
- 2/26- T.D. 3341- swabbed  
386 bbls 7 hrs.
- 3/5- Swabbing 50 bbls a  
day.
- 3/12- Sand 3316-41'  
T.D. 3341'  
Swab 459 bbls  
Comp.

Map No. KANSAS Sec. 21 Twp. 20 R. 10 N

Well No. 1 McGregor

Independent Oil & Gas Company

Contractor

# SECTION PLAT

|  |  |   |  |
|--|--|---|--|
|  |  |   |  |
|  |  |   |  |
|  |  | 0 |  |
|  |  |   |  |
|  |  |   |  |

.....Ft. from N. Line

320 Ft. from S. Line

.....Ft. from E. Line

320 Ft. from W. Line

## FIRST REPORTS

Location ✓

Rig up.....

Drilling and Remarks:

## RECORD

Cased.....in., .....ft.

Sand.....

Gas.....

Oil.....

Total Depth.....

## PRODUCTION

1st 24 hrs. Nat.....

1st 24 hrs. after shot.....

Gas.....Cu. Ft.

Dry Hole.....

Abandoned.....

Date

OCT 16 1929

192

S. J. LEWIS

Scout

Map No. KANSAS Sec. 21 Twp. 20 R. 10W

Well No. 11992

Independent Oil Co Company

Contractor

# SECTION PLAT

|  |  |   |  |
|--|--|---|--|
|  |  |   |  |
|  |  |   |  |
|  |  | 0 |  |
|  |  |   |  |
|  |  |   |  |

.....Ft. from N. Line

330 Ft. from S. Line

.....Ft. from E. Line

330 Ft. from W. Line

COMPLETED

Location.....

Rig up.....

Drilling and Remarks:

swath 45988 1/2

## RECORD

Cased.....in., .....ft.

Sand 3316 - 3341

Gas.....

Oil.....

Total Depth 3341

## PRODUCTION

1st 24 hrs. Nat.....

1st 24 hrs. after shot.....

Gas.....Cu. Ft.

Dry Hole.....

Abandoned.....

Date

MAR 12 1930

192

S. J. LEWIS

Scout