

KANSAS

Rice

Section 21 Township 20 Range 10-WWell No. #1 SchurrCompany Huber et al.
Raymond Pool

NORTH

WEST								EAST

SOUTH

KANSAS

Rice

Sec. 21 Twp. 20 R. 10-W

Well No. #1 Schurr Farm


Huber etal
Raymond Pool Company

990 Ft. from N. Line

 Ft. from S. Line

330 Ft. from E. Line

 Ft. from W. Line

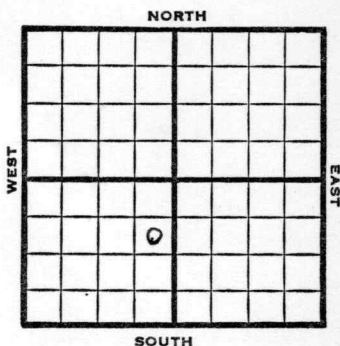

SE NE SW

1948

Elev. 1786' REPORT

10/13

8"@ 156

Drlg 2239'

10/19

Drlg. 3245'

10/26

Heverner 3245'

Sand 2285'

5" @ 2286'

11/3

Sand 2285'

5" @ 2286'

Pump 50 oil Pot.

Gr. 42°

TD 2295'

COMPLETED

Map No. _____ Sec. 21 Twp. 20 R. 10WWell No. 1 Schurr

Huber et al. _____ Company

FIRST REPORT

SE NE SW _____ Contractor


SECTION PLAT

990 Ft. from N. Line

_____ Ft. from S. Line

330 Ft. from E. Line

_____ Ft. from W. Line

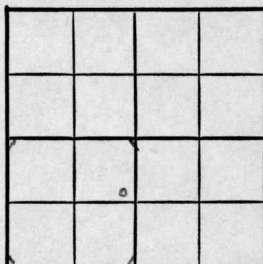

Rice County

Location _____

Rig up _____

Drilling and Remarks:

8" @ 156

drlg. 2239

RECORD

Cased _____ in., _____ ft.

Sand _____

Gas _____

Oil _____

Total Depth _____

PRODUCTION

1st 24 hrs. Nat. _____

1st 24 hrs. after shot _____

Gas _____ Cu. Ft.

Dry Hole _____

Abandoned _____

Date

OCT 13 1948 19

S. J. LEWIS

Scout

Map No. 76 Sec. 21 Twp. 20 R. 10W

Well No. 1 Schurr

Huber et al.

Company

COMPLETED

Contractor

SE NE SW


E. 1/4
SECTION PLAT

990 Ft. from N. Line

 Ft. from S. Line

330 Ft. from E. Line

 Ft. from W. Line

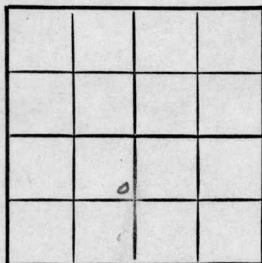

Rice County

RECORD

Location

Rig up

Drilling and Remarks:

San oil 2285

5" C 2286

Pump. 50 oil 100

420 ft

Cased in., ft.

Sand

Gas

Oil

Total Depth 2285

PRODUCTION

1st 24 hrs. Nat.

1st 24 hrs. after shot

Gas Cu. Ft.

Dry Hole

Abandoned

Date

NOV 3 1948

19

S. J. LEWIS

Scout