


Section 7 Township 18 S Range 6 WWell No. #1 TaylorCompany L. H. Isern Oil Co.

NORTH

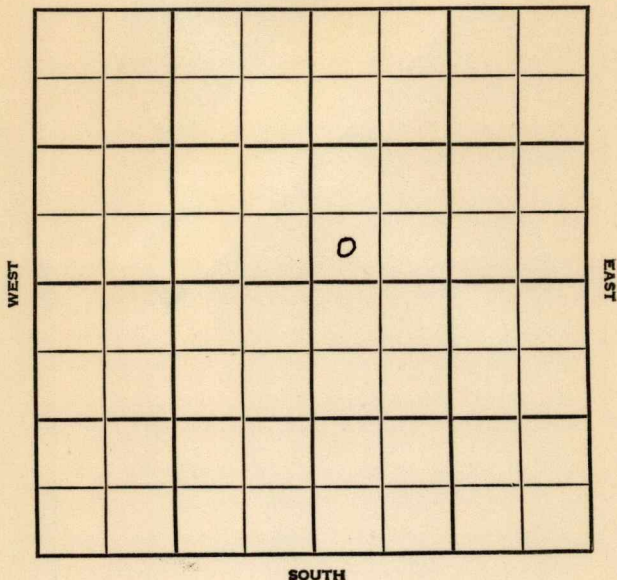

SOUTH

Rice

KANSAS

SEC.	TWP.	R.
7	18S	6W

WELL NO.

#1 Taylor

FARM

COMPANY

L. J. Isern Oil Co.

CONTRACTOR

Prime Drlg
Crawford


_____ Ft. from N. Line

_____ Ft. from S. Line

_____ Ft. from E. Line

_____ Ft. from W. Line

SW SW NE

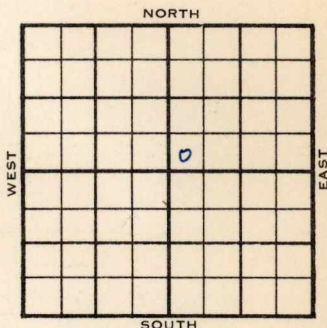

	ELEVATION	REPORT
1955	1685	

9/28

Comm 9-23-55
8" @ 201 w/150
D under surf

10/12

Comm 9-23-55
8" @ 201-150

H	2676
Tr	2707
Dg	2723
L	2846
Sd	3320
TD	3367

DST 3299-3332 open 1 hr Rec 200' msW
460/20"

D & A

ABANDONED

County Rice Elev. _____
 Sec. 7 Twp. 18S Rge. 6W
 Company L. J. Isern Oil Co.
 FarmName Taylor No. 1

TOPS	DEPTH	LOG	DATUM	Loc. in Sec.
Anh.				SW SW NE
Tp.				
H.				DS - NE 1/4
Tr.				
Dg.				
B.L.				
L.				Geol.
K.C.				Contr.
B.K.C.				Prime Drlg.
Ce.				rig #2
C.				Pool
M.				Crawford
M.				
K.				
Mz.				
Ma.				
V.				
S.				
S.				
A.				
R.				
Pe.				
G.				
T.D.				

Date Comm. 9-23-55 SEP 28 1955
8" 201 w/150; D under surf

12

Co.

Lse.

No.

Sec.

T.

R.

County Rice Elev. 1685
 Sec. 7 Twp. 18 Rge. 6W
 Company L. J. Isern oil
 Farm Name Taylor No. 1

TOPS	DEPTH	LOG	DATUM
Anh.			
Tp.			
H.	<u>2676</u>		<u>991</u>
Tr.	<u>2707</u>		<u>1032</u>
Dg.	<u>2723</u>		<u>1038</u>
Bl.			
L.	<u>2846</u>		<u>1161</u>
K.C.			
B.K.C.			
Ce.			
C. <u>sd.</u>	<u>3320</u>		<u>1635</u>
M.			
M.			
K.			
Mz.			
Me.			
V.			
S.			
S.			
A.			
R.			
Pe.			
G.			
T.D.	<u>3367</u>		

Loc. in Sec. _____

SW SW NE

Geol. _____

Contr. _____

Prime Drlg.

Pool _____

Crawford

ABANDONED

Date Comm. 9-23-55

OCT 12 1955

8" @ 201/150 DST 3299-3332 open 1 hr.

Rec. 200' msw 460/20"

D & A