


Map No. *Pice* *21* **KANSAS** Sec. *20* Twp. *10^w* R.

Well No. *Veckers* *Bingo* Farm
Bel Company

NORTH

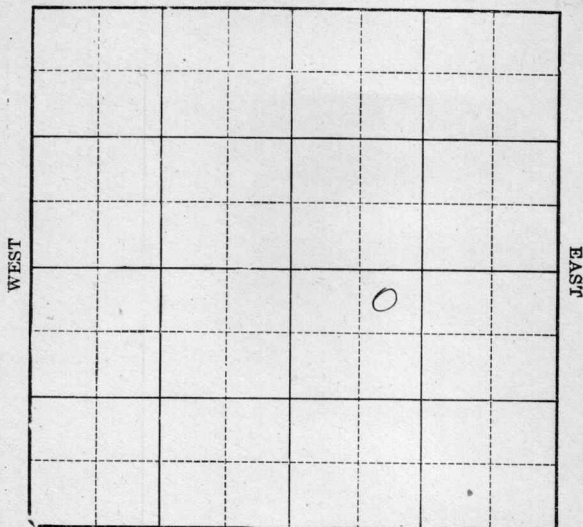

SOUTH

Location _____
Drilling Remarks _____

Rig Up _____
Drilling Remarks _____

RECORD

PRODUCTION

Cased _____ in. _____ ft.
Sand _____
Gas _____
Oil _____
Total Depth _____

1st 24 hrs. Nat. _____
1st 24 hrs. after shot _____
Gas _____ cu. ft.
Dry Hole _____
Abandoned _____

Map No. Rice KANSAS Sec. 21 Twp. 20 R. 10^w

Well No. 2- Ranger Farm

Vickers Pet Company


330 Ft. from N. Line

_____ Ft. from S. Line

_____ Ft. from E. Line

990 Ft. from W. Line

1930

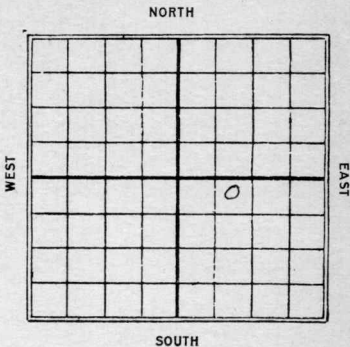

Date REPORT

Date	REPORT
5/21	Loc.
5/28	—
6/4	Rig
6/11	—
6/18	—
6/25	—
7/2	—
7/9	—
7/16	Rign up
7/23	—
7/30	rlg. 920'
8/6	" 1750'
8/13	U.R. 10" 2025'
8/20	8" 2582 Clogout 2595
8/27	rlg. 3845'
9/3	S.D. 3270 set 6"
9/10	— 10/22 — 12/3 —
9/17	— 10/29 — (over)
9/24	— 11/5 —
10/1	— 11/2 —
10/8	— 11/19 —
10/15	— 11/25 —

12/10 - Top Silc line 3340
Pcm 6" csg

12/17 - S.D. 3347 1/2' TD.
H.F. oil

12/23 —

12/30 —

1931

1/7 - Silc line 3340-48 1/2
TD. 3348 1/2
swab 30 bbl per hr
Comp.

Map No. 46 **KANSAS** Sec. 21 Twp. 20 R. 10 W
Well No. 2 Binger

Vic... Co. Company
Contractor

SECTION PLAT

330 Ft. from N. Line
..... Ft. from S. Line
..... Ft. from E. Line
990 Ft. from W. Line

		6	

FIRST REPORTS

Location ✓
Rig up
Drilling and Remarks:

RECORD

Cased.....in.,ft.
Sand.....
Gas.....
Oil.....
Total Depth.....

PRODUCTION

1st 24 hrs. Nat.....
1st 24 hrs. after shot.....
Gas.....Cu. Ft.
Dry Hole.....
Abandoned.....

Date

MAY 21 1930

192

S. J. LEWIS

Scout

Map No. KANSAS Sec. 21 Twp. 20 R. 10 W
 Well No. 2 Binger

Vickers P & S Company
 Contractor

SECTION PLAT

		o	

330 Ft. from N. Line
 Ft. from S. Line
 Ft. from E. Line
990 Ft. from W. Line

COMPLETED

Location.....

Rig up.....

Drilling and Remarks:

Sil line 3340 to 48 1/2

sway to 30 ft per hour.

RECORD

Cased.....in.,ft.
 Sand.....
 Gas.....
 Oil.....
 Total Depth 3348 1/2

PRODUCTION

1st 24 hrs. Nat.....
 1st 24 hrs. after shot.....
 Gas.....Cu. Ft.
 Dry Hole.....
 Abandoned.....

Date

JAN 7 1931

192.....

S. J. LEWIS

Scout