

Rice Co.

Map No. 18 Sec. 10 Twp. 18 R. 6Well No. 1 Walker Farm

*Forney Elwell et al* Company

*Jasper* NORTH *Becker*

Rosenthal

WEST

EAST

SOUTH

## Location

### Drilling Remarks

## Rig Up

### Drilling Remarks

## RECORD

Cased \_\_\_\_\_ in. \_\_\_\_\_ ft.

Sand \_\_\_\_\_

Gas

# Oil

Total Depth \_\_\_\_\_

## PRODUCTION

1st 24 hrs. Nat. \_\_\_\_\_

1st. 24 hrs. after shot

Gas \_\_\_\_\_ cu. ft.

## Dry Hole

Abandoned -----

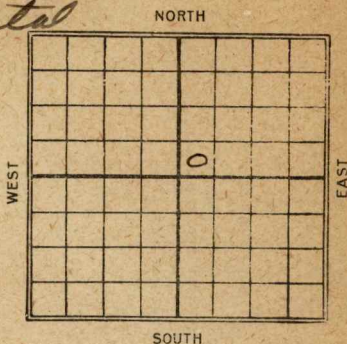
Rice Co

Map No. Kan Sec. 10 Twp. 18 R. 6<sup>W</sup>Well No. 1 Walker Farm~~Journey Elwell et al~~ Company~~Jasper + Brooks~~Rosenthal et al

Ft. from N. Line

200 Ft. from S. Line

Ft. from E. Line

200 Ft. from W. LineBeneau

Date

REPORT

192411/23 1750' S.D. in Litigation19251/21 S.D. 200019256/2 S.D. 204010/21 M.R. @ 30 ft19263/3 Abandoned 3511

Map No. **KANSAS** Sec. *10* Twp. *18* R. *6W*

Well No. *1 Walker*

*Forney Elwell et al* Company

Contractor

## FIRST REPORT

\_\_\_\_\_ Ft. from N. Line

*200'* \_\_\_\_\_ Ft. from S. Line

\_\_\_\_\_ Ft. from E. Line

*200'* \_\_\_\_\_ Ft. from W. Line

## SECTION PLAT

|  |  |   |  |
|--|--|---|--|
|  |  |   |  |
|  |  |   |  |
|  |  | o |  |
|  |  |   |  |
|  |  |   |  |

Location \_\_\_\_\_

Rig up \_\_\_\_\_

Drilling and Remarks:

*1750' s.d. in  
litigation*

## RECORD

Cased \_\_\_\_\_ in., \_\_\_\_\_ ft.

Sand \_\_\_\_\_

Gas \_\_\_\_\_

Oil \_\_\_\_\_

Total Depth \_\_\_\_\_

## PRODUCTION

1st 24 hrs. Nat. \_\_\_\_\_

1st 24 hrs. after shot \_\_\_\_\_

Gas \_\_\_\_\_ Cu. Ft.

Dry Hole \_\_\_\_\_

Abandoned \_\_\_\_\_

Date  
NOV 23 1924

M. A. BENEAR

\_\_\_\_\_ 192\_\_\_\_\_

\_\_\_\_\_ Scout



Map No. KANSAS Sec. 10 Twp. 18 R. 6 WWell No. 1 WalkerJasper & Bros Company

Contractor

## SECTION PLAT

----- Ft. from N. Line

200 Ft. from S. Line

----- Ft. from E. Line

200 Ft. from W. Line

|  |  |   |  |
|--|--|---|--|
|  |  |   |  |
|  |  | 0 |  |
|  |  |   |  |
|  |  |   |  |

Correction

Location -----

Rig up -----

Drilling and Remarks:

Rosenthalhas taken this  
over

## RECORD

Cased ----- in., ----- ft.

Sand -----

Gas -----

Oil -----

Total Depth -----

## PRODUCTION

1st 24 hrs. Nat. -----

1st 24 hrs. after shot -----

Gas ----- Cu. Ft.

Dry Hole -----

Abandoned -----

Date

NOV 11 1925

192

S. J. LEWIS

Scout

Map No. *Rice* **KANSAS** Sec. *10* Twp. *18* R. *6 W*

Well No. *1 Walker*

*Rosenthal & Dal.* Company

Contractor

## SECTION PLAT

\_\_\_\_\_ Ft. from N. Line

*200* Ft. from S. Line

\_\_\_\_\_ Ft. from E. Line

*200* Ft. from W. Line

|  |  |  |  |
|--|--|--|--|
|  |  |  |  |
|  |  |  |  |
|  |  |  |  |
|  |  |  |  |

**ABANDONED**

Location \_\_\_\_\_

Rig up \_\_\_\_\_

Drilling and Remarks:

*VII 3511*

*D & A.*

## RECORD

Cased \_\_\_\_\_ in., \_\_\_\_\_ ft.

Sand \_\_\_\_\_

Gas \_\_\_\_\_

Oil \_\_\_\_\_

Total Depth \_\_\_\_\_

## PRODUCTION

1st 24 hrs. Nat. \_\_\_\_\_

1st 24 hrs. after shot \_\_\_\_\_

Gas \_\_\_\_\_ Cu. Ft.

Dry Hole \_\_\_\_\_

Abandoned \_\_\_\_\_

Date

*MAR 3* 1926

*S. J. LEWIS*

Scout

MAP NO. KANSAS SEC. 10 TWP. 18S R. 6W

WELL NO. Walker

Jasper et al COMPANY

CONTRACTOR

SECTION PLAT

|  |  |  |  |
|--|--|--|--|
|  |  |  |  |
|  |  |  |  |
|  |  |  |  |
|  |  |  |  |
|  |  |  |  |

ABANDONED

\_\_\_\_\_ FT. FROM N. LINE

\_\_\_\_\_ FT. FROM S. LINE

\_\_\_\_\_ FT. FROM E. LINE

\_\_\_\_\_ FT. FROM W. LINE

O.K.

LOCATION \_\_\_\_\_

RIG UP \_\_\_\_\_

DRILLING AND REMARKS:

checked  
with our  
map

RECORD

CASED \_\_\_\_\_ IN. \_\_\_\_\_ FT.

SAND \_\_\_\_\_

GAS \_\_\_\_\_

OIL \_\_\_\_\_

TOTAL DEPTH 3511

PRODUCTION

1ST 24 HRS. NAT. \_\_\_\_\_

1ST 24 HRS. AFTER SHOT \_\_\_\_\_

GAS \_\_\_\_\_ CU. FT.

DRY HOLE ☒

ABANDONED ☒

DATE

3/3 1926

SCOUT