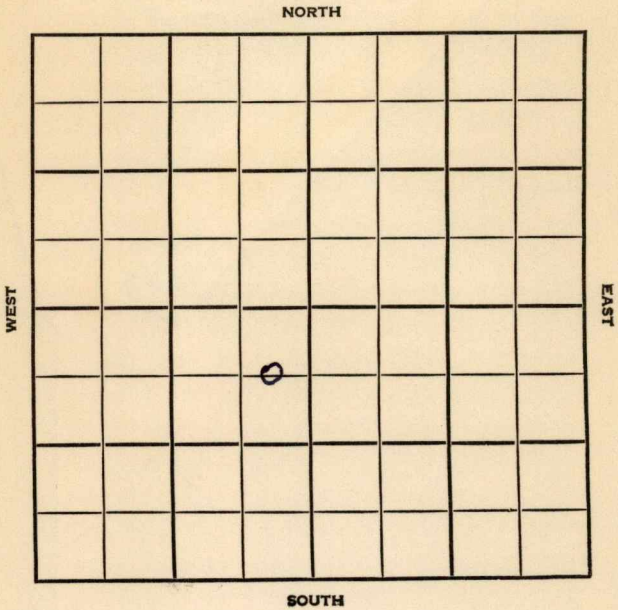


Section 17 Township 18 Range 6WWell No. 1 Sophia TaylorCompany Riggs & Derby

Rice KANSAS

SEC.	TWP.	R.
17	18	6W ✓
WELL NO.		
1 Sophia Taylor		FARM
COMPANY		
Riggs & Derby		
CONTRACTOR		
Riggs-Contr		


660 Ft. from N. Line

Ft. from S. Line

330 Ft. from E. Line

C E $\frac{1}{2}$ NE SW Ft. from W. Line

C E $\frac{1}{2}$ NE SW

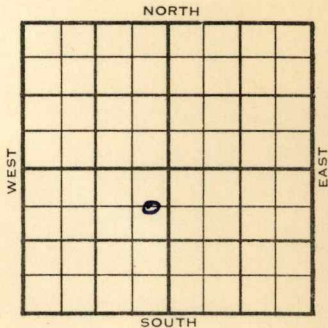

	ELEVATION	REPORT
1954	1696'	
6/15	Spdg 6-10-54 Drlg. 2045	
6/23	Spud 6-10-54 - D&A TD 3499' 8" @ 145' Top 2398', Heeb 2686', Lans 2854' DST 3218-63', opn 1 hr., rec. 15' mud, 335# Cong 3398', Miss 3465' TD 3499' D&A	
		ABANDONED

County Rice State Kansas
 Sec. 17 (Blk.) 18 (Sur.) 6W Map No. (Twp.) (Rge.)
 Operator Riggs & Derby
 Well No. 1 Farm Sophia Taylor
 Elev. 1696 Location C E $\frac{1}{2}$ NE SW



660 Ft. From N Line SW
330 Ft. From E Line Quarter

1st. Report

Completion JUN 23 1954

Remarks

Riggs - Contr.

Spudding Date 6-10-54

Drig. Data D & A TD 3499

8" @ 145 Top. 2398 Heeb. 2686

Lans. 2854 DST 3218-63 open 1 hr.

Rec. 15' mud 335# Cong. 3398

Miss. 3465 TD 3499

D & A

J. G. McGEHEE