

Map No. _____ Sec. 21 Twp. 20 R. 10W


Well No. 2-Thompson Farm
Texas Co Company

_____ Ft. from N. Line

330 Ft. from S. Line

_____ Ft. from E. Line

330 Ft. from W. Line

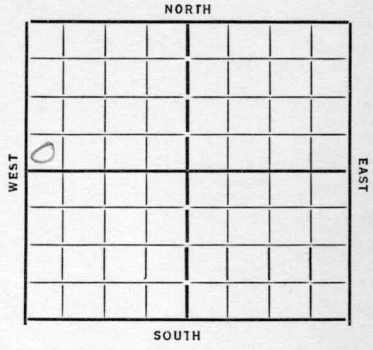

Date
1933

REPORT

7/19 location

7/26 Rig up

8/2 —

8/9 12" - 168 drly 1573'

8/17 drly 2650'

8/23 " 3128'

8/30 Siliceous 3337-8' 3338 feet

9/6 pay 3337-47 - 2750' 6 hrs
T.D. 3349

9/13 Siliceous 3337
T. D. 3349
895 bbls

COMPLETED

KANSAS

Map No. 46 Sec. 21 Twp. 20 R. 10W

Well No. 2-Thompson

Texas Co Company

Contractor

SECTION PLAT

0			

.....Ft. from N. Line

330 Ft. from S. Line

.....Ft. from E. Line

330 Ft. from W. Line

FIRST REPORTS

Location

Rig up

Drilling and Remarks:

RECORD

Cased.....in.,ft.

Sand.....

Gas.....

Oil.....

Total Depth.....

PRODUCTION

1st 24 hrs. Nat.....

1st 24 hrs. after shot.....

Gas.....Cu. Ft.

Dry Hole.....

Abandoned.....

Date

7/19/33 192 Carl Mannsheek Scott

Map No. 46 Sec. 21 Twp. 20 R. 10W

Well No. 2-Thompson

Texas Co Company

Contractor

SECTION PLAT

Ft. from N. Line

330 Ft. from S. Line

Ft. from E. Line

330 Ft. from W. Line

0			

COMPLETED

Location.....

Rig up.....

Drilling and Remarks:

895 bbls

RECORD

Cased..... in., ft.

Sand bluious 3337

Gas.....

Oil.....

Total Depth 3349

PRODUCTION

1st 24 hrs. Nat.....

1st 24 hrs. after shot.....

Gas..... Cu. Ft.

Dry Hole.....

Abandoned.....

Date

9/13/33 Oreal Mannschreck Secut