


Rice
 Form 51-5M-2-29-34703
 Map No. **KANSAS** Sec. 21 Twp. 20 R. 10th
 Well No. 3 Binger Farm
Veckers Pet Company

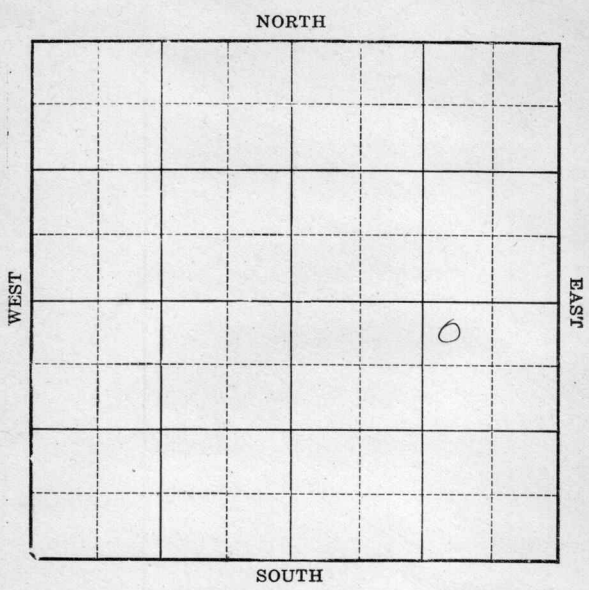

Location _____

Drilling Remarks _____

Rig Up _____

Drilling Remarks _____

RECORD

Cased _____ in. _____ ft.

Sand _____

Gas _____

Oil _____

Total Depth _____

PRODUCTION

1st 24 hrs. Nat. _____

1st 24 hrs. after shot _____


Gas _____ cu. ft.

Dry Hole _____

Abandoned _____

Map No. KANSAS Sec. 21 Twp. 20 R. 10^w
 Well No. 3-Binger Farm
Vickers Pet Company

NORTH

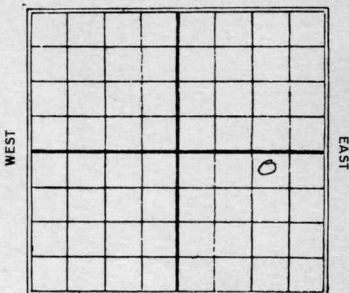

SOUTH

330 Ft. from N. Line

_____ Ft. from S. Line

940 Ft. from E. Line

1930 Ft. from W. Line

Date

REPORT

5/21	Loc.
5/28	Bldg. rig
6/7	Spud
6/11	Perlg. 950'
6/18	" 1675'
	show gas. 1406
6/25	2 1/2" 10" 2000'
7/2	Perlg. 2300'
	10" - 2020'
7/9	Perlg. 2750'
	7 7/8" 2575'
7/16	Perlg. 3145'
	8" - 2612'
7/23	S.D. 3260'
7/30	S.D. 3277'
8/6	— 9/24 — 11/12 —
8/13	— 10/1 — 11/19 —
8/20	— 10/8 — 11/25 —
8/27	— 10/15 — 12/3 —
9/3	— 10/22 — (over)
9/10	— 10/29 —
9/17	— 11/5 —

12/10 - Drly 3287
12/17 - Top Silc line 3346
SD 3358' H.F. oil

12/23 —

12/30 —

1931.

1/7 - Silc line 3346-58
TD. 3358

swab 20 bbl per hr
Comp.

Map No. **KANSAS** Sec. 21 Twp. 20 R. 10W

Well No. 3 Binger

Vickers P.D. Company

Contractor

SECTION PLAT

830 Ft. from N. Line

..... Ft. from S. Line

990 Ft. from E. Line

..... Ft. from W. Line

FIRST REPORTS

Location ✓

Rig up

Drilling and Remarks:

RECORD

Cased..... in., ... ft.

Sand

Gas

Oil

Total Depth

PRODUCTION

1st 24 hrs. Nat.

1st 24 hrs. after shot

Gas..... Cu. Ft.

Dry Hole

Abandoned

Date

MAY 21 1930

192

S. J. LEWIS Scout

Map No. 46 **KANSAS** Sec. 21 Twp. 20 R. 10 W
Well No. 3 Binger

Vickers P. & S. Company

Contractor

SECTION PLAT

330 Ft. from N. Line

..... Ft. from S. Line

990 Ft. from E. Line

..... Ft. from W. Line

			0

COMPLETED

Location.....

Rig up.....

Drilling and Remarks:

Oil line 3346 &
3358.

soak 20 hrs per
hour.

RECORD

Cased.....in., ...ft.

Sand.....

Gas.....

Oil.....

Total Depth 3358.

PRODUCTION

1st 24 hrs. Nat.....

1st 24 hrs. after shot.....

Gas.....Cu. Ft.

Dry Hole.....

Abandoned.....

Date

JAN 7 1931 192..... S. J. LEWIS Scout