

KANSAS

Rice

Section 21 Township 20 Range 10WWell No. 2 BingerCompany Huber et al - Labco.
Raymond

NORTH

WEST

EAST

SOUTH

KANSAS

Rice

Sec. 21 Twp. 20 R. 10W ✓

Well No. #2 Binger Farm

Huber et al

Company

Raymond Pool (Paboc Drlg. Cont.)


NORTH

990' Ft. from N. Line

 Ft. from S. Line

 Ft. from E. Line

990' Ft. from W. Line

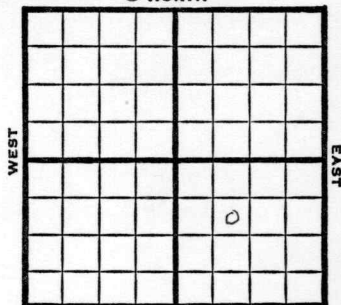

SE NW SE

SOUTH

1949

Elev 1780'

REPORT

6/1 Location
6/7 8"@ 117'
Drlg 980'
6/15 Indian Cave 2302'
TD 2570'
5"@ 2561'
6/21 "
6/28 "
7/6 "
7/12 "
7/20 "
7/27 "
8/3 "
8/10 "
8;17 TD 2570'

Indian Cave 2210'

Aband.

ABANDONED

Sec. 21 Twp. 20 R. 6-W ✓

Well No. #2 Binger Farm

Pabco Company

Raymond Pool


990 Ft. from N. Line

 Ft. from S. Line

 Ft. from E. Line

990 Ft. from W. Line

SE NW SE

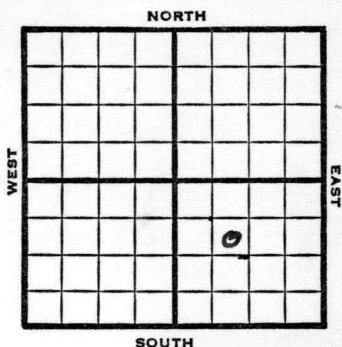

1949

REPORT

8/10

Location

8/31

TD 2574'

Indian Cave 2210'

5 @ 2561'

Aband. Aug 17, 1949

Aband.

ABANDONED

Map No. _____ Sec. 21 Twp. 20 R. 10W

Well No. 2 Binger

Huber etal. Company

Pabco Drlg. Contractor

SE NW SE


FIRST REPORT
SECTION PLAT

990 Ft. from N. Line

_____ Ft. from S. Line

_____ Ft. from E. Line

990 Ft. from W. Line

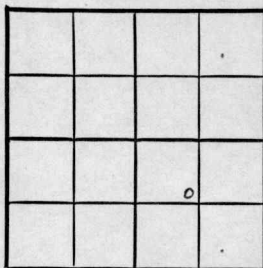

Rice County

Location X

Rig up _____

Drilling and Remarks:

RECORD

Cased _____ in., _____ ft.

Sand _____

Gas _____

Oil _____

Total Depth _____

PRODUCTION

1st 24 hrs. Nat. _____

1st 24 hrs. after shot _____

Gas _____ Cu. Ft.

Dry Hole _____

Abandoned _____

Date

JUN 1 1949 19 S. J. LEWIS Scout

Kansas

Map No. _____ Sec. 21 Twp. 20 R. 6WWell No. 2 Binger

Pabco

Company

CORRECTION

Contractor

SE NW SE

SECTION PLAT

990


Ft. from N. Line

Ft. from S. Line

Ft. from E. Line

990

Ft. from W. Line

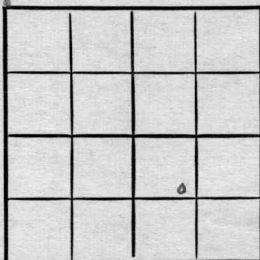

Rice County

RECORD

Location _____

Cased _____ in., _____ ft.

Rig up _____

Sand _____

Drilling and Remarks:

Gas _____

Oil _____

Total Depth _____

They took this
over from
Huber etal.

PRODUCTION

1st 24 hrs. Nat. _____

1st 24 hrs. after shot _____

Gas _____ Cu. Ft.

Dry Hole _____

Abandoned _____

Date

AUG 10 1949

19

S. J. LEWIS

Scout

Kansas

Raymond Pool

Map No. _____ Sec. 21 Twp. 20 R. 10WWell No. 2 Binger

Pabco

Company

ABANDONED


Contractor

SE NW SE

*E 41780***SECTION PLAT**990 Ft. from N. Line

_____ Ft. from S. Line

_____ Ft. from E. Line

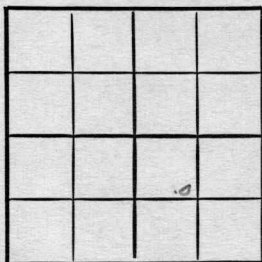990 Ft. from W. Line

Rice County

RECORD

Location _____

Cased _____ in., _____ ft.

Rig up _____

Sand _____

Drilling and Remarks:

Gas _____

Oil _____

Total Depth 2570**PRODUCTION**

1st 24 hrs. Nat. _____

1st 24 hrs. after shot _____

Gas _____ Cu. Ft.

Dry Hole _____

Abandoned _____

Date

AUG 17 1949 19S. J. LEWIS

Scout

Kansas

Raymond Pool

Map No. K46 Sec. 21 Twp. 20 R. 10WWell No. 2 Binger

Pabco


Company

ABANDONED

Contractor

SE NW SE

SECTION PLAT

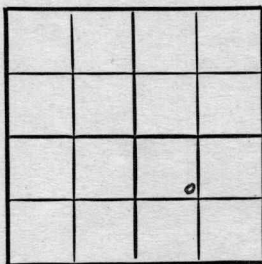990 Ft. from N. Line Ft. from S. Line Ft. from E. Line990 Ft. from W. Line

Rice County

RECORD

Location Rig up

Drilling and Remarks:

Indian cave

2210

5" @ 2561

abandoned

Aug. 17, 1949

Cased in., ft.Sand Gas Oil Total Depth 2574

PRODUCTION

1st 24 hrs. Nat. 1st 24 hrs. after shot Gas Cu. Ft.Dry Hole Abandoned

Date

AUG 31 1949

19

S. J. LEWIS

Scout