

KANSAS


FORM 51 5M 4-41 PETROL

Rice

Section 17 Township 18 Range 6-W

Well No. 1 S. M. Taylor

Company Continental

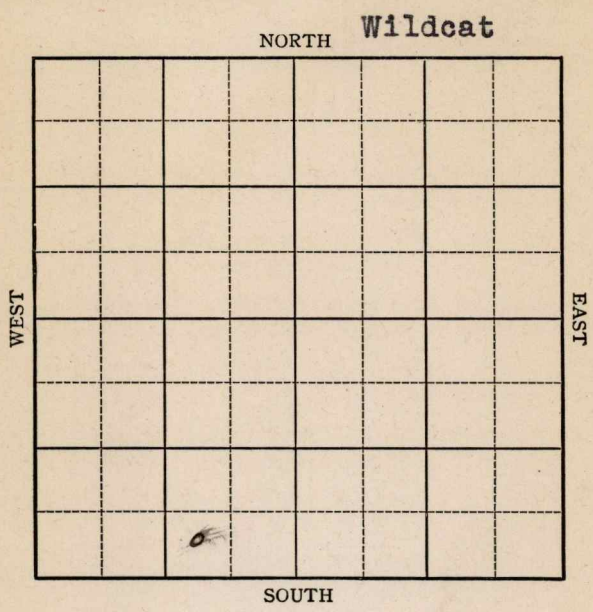



Map No. 44 Sec. 17 Twp. 18 R. 6WWell No. 1 S. M. TaylorContinental

Company


Contractor

**FIRST REPORT**

SW SE SW

       Ft. from N. Line330 Ft. from S. Line990 Ft. from E. Line       Ft. from W. Line

WILDCAT

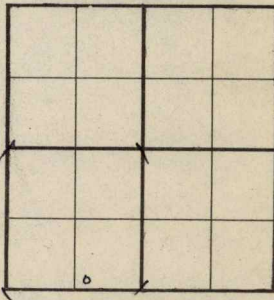**SECTION PLAT**Location                     Rig up                     Drilling and Remarks:  
Rotary**RECORD**Cased            in.,            ft.Sand                     Gas                     Oil                     Total Depth                     **PRODUCTION**1st 24 hrs. Nat.                     1st 24 hrs. after shot                     Gas                      Cu. Ft.Dry Hole                     Abandoned                     

Date

APR 30 1941 19

S. J. LEWIS Scout

Map No. 44 Sec. 17 Twp. 18 R. 6WWell No. 1 S. M. TaylorContinental

Company

ABANDONED

Contractor

## SECTION PLAT

SW SE SW

       Ft. from N. Line330 Ft. from S. Line990 Ft. from E. Line       Ft. from W. Line

WILDCAT

|  |  |  |  |
|--|--|--|--|
|  |  |  |  |
|  |  |  |  |
|  |  |  |  |
|  |  |  |  |

Location                     Rig up                     

Drilling and Remarks:

*Miss 3298**7" @ 3300**AFW.*

## RECORD

Cased            in.,            ft.Sand                     Gas                     Oil                     Total Depth 3368

## PRODUCTION

1st 24 hrs. Nat.                     1st 24 hrs. after shot                     Gas                      Cu. Ft.Dry Hole                     Abandoned                     

Date

MAY 21 1941 19

S. J. LEWIS Scout