


Farm

NORTH

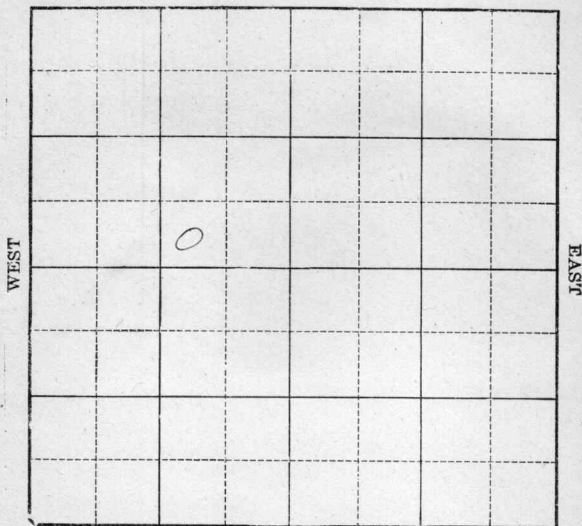


SOUTH

Abandoned

Map No. KANSAS Sec. 21 Twp. 20 R. 10^w
 Well No. 2 Thompson Farm
Producers & Refiners Company

NORTH

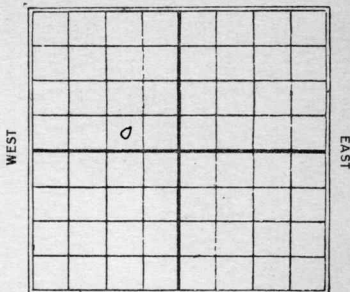

 Ft. from N. Line

330 Ft. from S. Line

990 Ft. from E. Line

1930 Ft. from W. Line

Date

REPORT

7/23	Loc
7/30	
8/6	Roll
8/13	Rig
8/20	Rig up
8/27	hrlg. 445'
9/3	" 1285'
9/10	" 1800'
9/17	" 2090'
9/24	" 2125'
10/1	" 2195'
	10" - 2154'
10/8	show oil 2570-80 dry 2592'
10/15	SD 2593 repairs
10/22	
10/29	dry 2865'
11/2	show oil & gas 3065' more gas 3090-95' 6" - 3122' hrlg. 3128'
11/12	hrlg. 3250'
	(over)

11/19- Top Sil. line 3327
T.D. 3344½

Swab 45 bbl per hr

11/25- Sil line 3327-44½
T.D. 3344½

Swab 1000 bbl

Comp.

Map No. **KANSAS** Sec. **21** Twp. **20** R. **10W**

Well No. **2 Thompson**

Producers & Ref. Company

Contractor

SECTION PLAT

 Ft. from N. Line

380 Ft. from S. Line

990 Ft. from E. Line

 Ft. from W. Line

FIRST REPORTS

Location ✓

Rig up

Drilling and Remarks:

RECORD

Cased in., ft.

Sand

Gas

Oil

Total Depth

PRODUCTION

1st 24 hrs. Nat.

1st 24 hrs. after shot

Gas Cu. Ft.

Dry Hole

Abandoned

Date

JUL 23 1930

19

S. J. LEWIS Scout

Map No. KANSAS Sec. 21 Twp. 20 R. 10 W

Well No. 2 Thompson

Producers & Ref. Company

Contractor

SECTION PLAT

..... Ft. from N. Line

330 Ft. from S. Line

990 Ft. from E. Line

..... Ft. from W. Line

	0		

COMPLETED

Location.....

Rig up.....

Drilling and Remarks:

Oil line 3827 &
44 1/2.

2100 & 1000 & 1/2

RECORD

Cased.....in., ...ft.

Sand.....

Gas.....

Oil.....

Total Depth 3344 1/2

PRODUCTION

1st 24 hrs. Nat.....

1st 24 hrs. after shot.....

Gas.....Cu. Ft.

Dry Hole.....

Abandoned.....

Date

NOV 25 1930 192.....

S. J. LEWIS Scout