

Rice

KANSAS

21

20

10 W


Section _____ Township _____ Range _____

2 Shurr

Well No. _____

Company Pabco Drlg.

NORTH

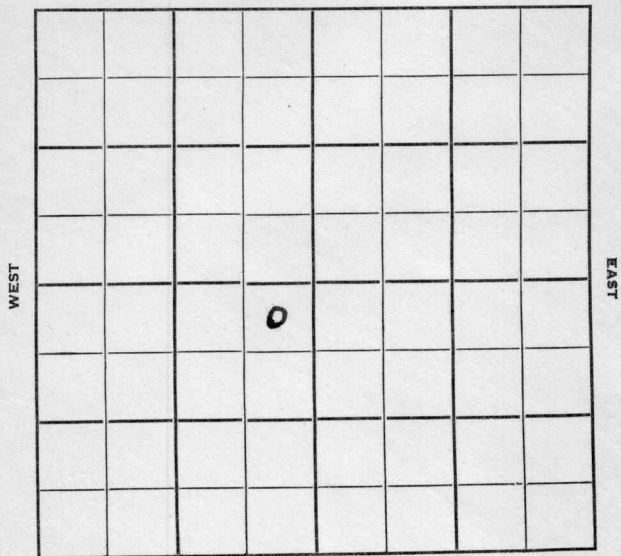

SOUTH

Rice

KANSAS ✓

Sec. 21 Twp. 20 R. 10W

Well No. #2 Shurr Farm

Pabco Drlg. Company

Contractor


340 Ft. from N. Line

_____ Ft. from S. Line

340 Ft. from E. Line

_____ Ft. from W. Line

NE NE SW (TWIN WELL)

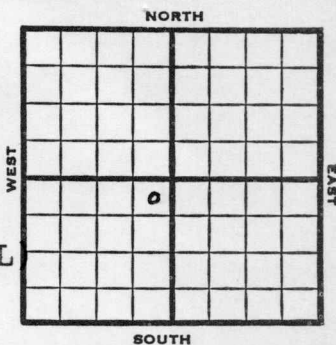

1952 Elev. 1766' REPORT

11/26 Drlg.

12/4 Howard 2475, Severy sha 2526, Severy sd 2544, Topeka 2570, Heeb 2846, Br li 2974, Lans 2997, Cong. 3267, Simp sd 3269 Arb 3304 RTD 3306, 5" @ 3306'

12/11 NR

12/18 NR

~~12/25~~ NR

1/1 NR

1/8 NR

1/23 Spud 11-12-52
 Oil well TD 3306' 8" @ 98
 DST 2173-2200 open 1 hr. rec 62' SOCM & 1813' wtr. 700# Howard 2475' Severy sh. 2526' Severy sd 2544' DST 2534-46 open 1 hr. rec 75' 0 & GCM 710# Top. 2570' Heeb 2846' Br. lime 2974' Lans. 2997' Cong. 3267' DST 3269-74 open 1 hr. rec 4' mud Simp. sd 3269' DST 3300-3303 open 1 hr. rec 7' mud 125# Arb. 3304'

OVER

1953
1/23

(Information continued)

DST 3302-06 open 1 hr, rec 1320' wtr.
1090#

DST 3265-85 open 1½ hr. rec 350' OCM
180' wtr. 1170# TD 3306'

5" @ 3306 48/3276-82 SSO

500 A S/1 GO 25 GWPH 20 qt/3272-

80 S/4½ BO 4½ BW 3 hrs.

Comp. 25 BQPD

COMPLETED

Orig. Data

S/ $4\frac{1}{2}$ bo $4\frac{1}{2}$ bw 3 hr.

Comp. 25 bopd

.....	MSC.
.....	Police Map
.....	France Map
.....	Trains
.....	Land Wall Map
.....	Land Small Map
.....	Scout Cards

Handwritten: 3
m m

JAN 29 1953