



Rice **KANSAS**

Sec. 21 Twp. 20 R. 10W ✓

Well No. #3 Binger Farm

Huber et al Company

Raymond Pool

Ft. from N. Line


330'

Ft. from S. Line

Ft. from E. Line

990'

Ft. from W. Line

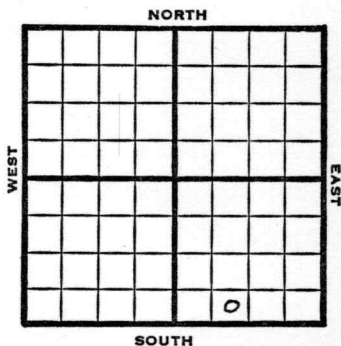

SE SW SE

1949

Elev. 1760' REPORT

6/15

8" @ 125'

6/21

Drlg. 1260'

Indian Cave 2270'

Lansing 2998'

TD 3092

5" @ 3077'

6/28

"

7/6

"

7/12

"

7/20

"

7/27

Indian Cave 2270'

5" @ 3077'

Lans. 2998'

Perf. Indian Cave

Pump 15 Oil & 10 W Pot.

Gr. 37°

TD 3092'

**COMPLETED**



