


*Rice*

Map No. *KANSAS* Sec. *21* Twp. *20* R. *10<sup>W</sup>*  
 Well No. *3* *Mitzy gu* Farm  
*Phillips Pet.* Company

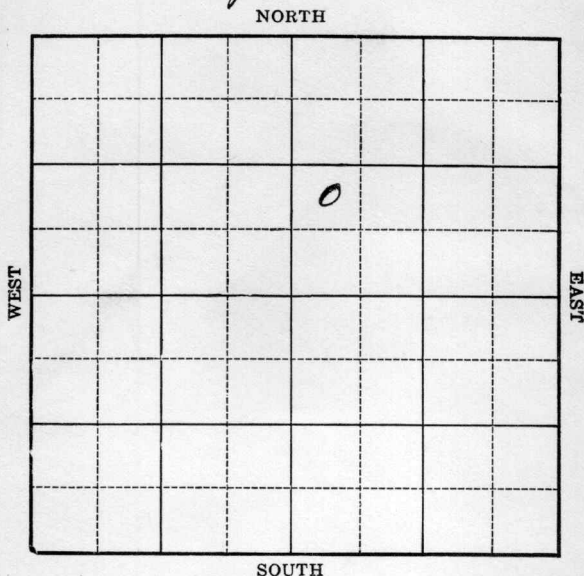

Location \_\_\_\_\_  
 Drilling Remarks \_\_\_\_\_

Rig Up \_\_\_\_\_  
 Drilling Remarks \_\_\_\_\_

**RECORD**

Cased \_\_\_\_\_ in. \_\_\_\_\_ ft.  
 Sand \_\_\_\_\_  
 Gas \_\_\_\_\_  
 Oil \_\_\_\_\_  
 Total Depth \_\_\_\_\_

**PRODUCTION**


1st 24 hrs. Nat. \_\_\_\_\_  
 1st 24 hrs. after shot \_\_\_\_\_  
 Gas \_\_\_\_\_ cu. ft.  
 Dry Hole \_\_\_\_\_  
 Abandoned \_\_\_\_\_

Rice

Map No. KANSAS Sec. 21 Twp. 20 R. 10<sup>W</sup>

Well No. 3 Metzger Farm  
Phillips Pet. Company

NORTH

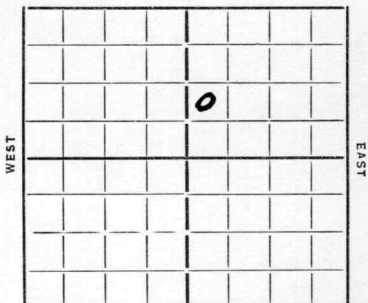

SOUTH

           Ft. from N. Line

990 Ft. from S. Line

           Ft. from E. Line

330 Ft. from W. Line

Date 1934

REPORT

|       |                |           |             |
|-------|----------------|-----------|-------------|
| 9/12  | Bldg           |           |             |
| 9/20  | Rig            |           |             |
| 9/27  |                |           |             |
| 10/4  | Spud           |           |             |
| 10/11 | Bldg 550       |           |             |
| 10/18 | " 1220         | 15 1/2    | 434         |
| 10/25 | " 1775         | 12 1/2    | 1540        |
| 11/1  | " 2005         | 10"       | 1931        |
| 11/8  | 10" 1975       | 2240      | Hole Casing |
| 11/15 | A.O. 2312-15   | NR 8"     | 2540        |
| 11/22 | HFW. 2585-90   | T 17      | 2606        |
|       | NR 8"          |           |             |
| 11/28 | Bldg 2905      | 8"        | 2601        |
| 12/6  | " 3194         | KE        | 3022        |
| 12/13 | A.O. 3090      | A.O. 3220 | Cong 3285   |
|       | Simpson 3305   | Silicious | 3333        |
|       | run 6"         |           |             |
| 12/21 | T 17 3337      | 5000'     | oil tubing  |
| 12/26 | Silicious 3333 | T 17 3337 |             |
|       | 1439 oil       | Pat.      |             |

COMPLETED

KANSAS

Map No. 46 Sec. 21 Twp. 20 R. 10WWell No. 3-MetzgerPhillips pet

Company

Contractor

## SECTION PLAT

|  |  |   |  |
|--|--|---|--|
|  |  |   |  |
|  |  | 0 |  |
|  |  |   |  |
|  |  |   |  |
|  |  |   |  |

FIRST REPORTS

       Ft. from N. Line990 Ft. from S. Line       Ft. from E. Line330 Ft. from W. LineLocation       Rig up       

Drilling and Remarks:

Bedg

## RECORD

Cased        in.,        ft.Sand       Gas       Oil       Total Depth       

## PRODUCTION

1st 24 hrs. Nat.       1st 24 hrs. after shot       Gas        Cu. Ft.Dry Hole       Abandoned       

Date

7-12-31 19

ORVAL MANNSCHRECK

Scout

Map No. 46 Sec. 21 Twp. 20 R. 10WWell No. 3-MetzgerPhillips pet. Company

Contractor

COMPLETED

## SECTION PLAT

|  |  |   |  |
|--|--|---|--|
|  |  |   |  |
|  |  | 0 |  |
|  |  |   |  |
|  |  |   |  |

Ft. from N. Line

990 Ft. from S. Line

Ft. from E. Line

330 Ft. from W. Line

Location

Rig up

Drilling and Remarks:

1439 oil  
natural

## RECORD

Cased \_\_\_\_\_ in., \_\_\_\_\_ ft.  
 Sand siliceous 3333  
 Gas \_\_\_\_\_  
 Oil \_\_\_\_\_  
 Total Depth 3337

## PRODUCTION

1st 24 hrs. Nat. \_\_\_\_\_  
 1st 24 hrs. after shot \_\_\_\_\_  
 Gas \_\_\_\_\_ Cu. Ft.  
 Dry Hole \_\_\_\_\_  
 Abandoned \_\_\_\_\_

Date

12-26-34 192 \_\_\_\_\_ Scout

ORVAL MANNSCHRECK