
DX 78-1

Rice KANSAS

Section 18 Township 18 Range 6W

Well No. 4 Brinckerhoff

Company Sun Oil

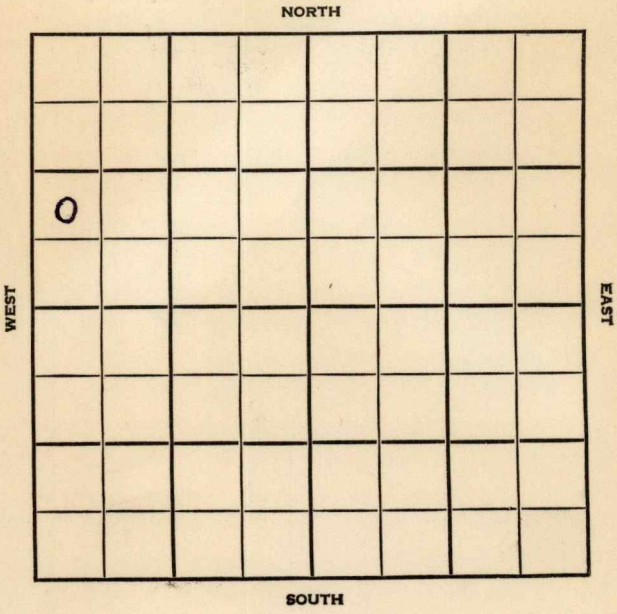

Rice KANSAS

SEC.	TWP.	R.
18	18	6W

WELL NO.

4 Brinckerhoff FARM


COMPANY

Sun Oil

CONTRACTOR

Cappitt

Crawford Pool

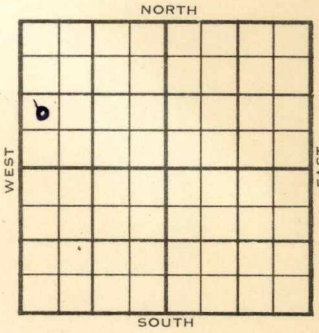

_____ Ft. from N. Line

990 Ft. from S. Line

_____ Ft. from E. Line

330 Ft. from W. Line

NW SW NW

1954	ELEVATION 1693'	REPORT

8/18 Spud 8-16-54
8" @ 246'

9/15 Spud 8-16-54 D & A TD 3215
8" @ 246 Lans. 2736 Cong 3191
Cong. sh. 3168 TD 3215 5" @ 3213
Schl tops: Br. lime 2703 Lans 2741
Cong. sh 3173 Cong sd 3191
64/3186-3202 sd-frac FU 3000' oil
S/113 BO 18 BSW CO to 3201
40/3187-97 B/14 GWPH sd-frac
S/478 BW D & A

ABANDONED

DX-78

FORM 275 FOR SALE BY KANSAS BLUE PRINT CO.

County Rice State Kansas

Sec. 18 (Blk. Twp.) 18 (Sur. Rge.) 6W Map No.

Operator Sun Oil

Well No. 4 Farm Brinckerhoff

Elev. Location NW SW NW



990 Ft. From S Line NW

330 Ft. From W Line Quarter

1st. Report AUG 18 1954

Completion

Remarks Cappit - Contr.

Spudding Date 8-16-54

Crawford Pool

Drlg. Data

8" @ 246

FABEN GILSTRAP

FORM 275 FOR SALE BY KANSAS BLUE PRINT CO.

County Rice State Kansas

Sec. 18 (Blk. Twp.) 18 (Sur. Rge.) 6W Map No.

Operator Sun Oil

Well No. 4 Farm Brinckerhoff

Elev. 1693 Location NW SW NW



990 Ft. From S Line NW

330 Ft. From W Line Quarter

1st. Report

Completion SEP 15 1954

Remarks Crawford Pool
Cappit - Contr.

Spudding Date 8-16-54

Drlg. Data D & A TD 3215

8" @ 246 Lans. 2736 Cong. 3191

Cong. sh. 3168 TD 3215 5" @ 3213

SCHLUMBERGER TOPS

Br. lime 2703 Lans. 2741 Cong.

sh. 3173 Cong. sd. 3191 64/ 3186-

3202 sd-frac FU 3000' oil

S/ 113 bo 18 bsw CO to 3201

40/ 3187-97 B/ 14 gwph sd-frac

S/ 478 bw

D & A

FABEN GILSTRAP