

Form 51-5M-11-31-Palace
Map No. **KANSAS** Sec. 24 Twp. 20 R. 10^W
Well No. 3 West Farm
Texas Co Company

NORTH

WEST

EAST

SOUTH

O. W. D. D.

Location _____

Drilling Remarks

Rig Up

Drilling Remarks

RECORD

Cased _____ in. _____ ft.

Sand

Gas

Oil

Total Depth.....

PRODUCTION

1st 24 hrs. Nat.-----

1st 24 hrs. after shot-----

Gas _____ cu. ft.

Dry Hole

Abandoned

Rice

Map No. KANSAS Sec. 21 Twp 20 R. 10W


Well No. 3-West Farm
Texas Co Company

330 Ft. from N. Line

_____ Ft. from S. Line

_____ Ft. from E. Line

850 ⁸¹⁰ Ft. from W. Line

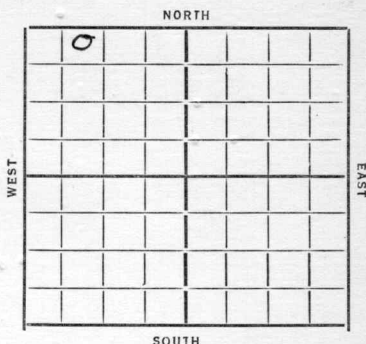

Date

1933

REPORT

O. W. D. D

10/4 location

10/11 Rig

10/18 —

10/25 12" at 116' Drlg 1760

11/1 Drlg 2735

11/8 K.C. Lime 3047 - 8" at 3100
T.D. 3132

11/15 R.U.S.T.

11/22 600' oil in hole

11/28 K.C. Lime 3047-3112
288 fbls COMPLETED

1939 O. W. D. D

5/24 Kansas City 3047'

Old T.D. 3132'

Fishing 3180'

6/1 Drlg. 3217'

6/8 7" @ 3277' Cong. 3300

Simpson 3313 Arb. 3342'

T.D. 3346' 1700' fluid

50% water. Run liner.

OVER

1939

6/16 Pump $17\frac{1}{2}$ oil, 48 water 6 hrs.
off bottom. Testing.

6/21 Arb. 3342'

T.D. 3346'

7" - 3277'

76' of 5" liner 3346'

Pump 85 bbls., potential.

COMPLETED

Map No. 46 Sec. 21 Twp. 20 R. 10W

Well No. 3-West

Texas Co Company

Contractor

SECTION PLAT

330 Ft. from N. Line

..... Ft. from S. Line

..... Ft. from E. Line

850 Ft. from W. Line

0			

Location ✓

Rig up

Drilling and Remarks:

RECORD

Cased in., ft.

Sand

Gas

Oil

Total Depth

PRODUCTION

1st 24 hrs. Nat.

1st 24 hrs. after shot

Gas Cu. Ft.

Dry Hole

Abandoned

Date

OCT 4 1933 O. Mannech Scout

Map No. 46 Sec. 21 Twp. 20 R. 10WWell No. 3 - westTexas Co Company

Contractor

COMPLETED

SECTION PLAT

0			

330 Ft. from N. Line

Ft. from S. Line

Ft. from E. Line

850 Ft. from W. Line

Location

Rig up

Drilling and Remarks:

RECORD

Cased in, ft.

Oil. Line 3049

Gas

Oil

Total Depth 3131

PRODUCTION

1st 24 hrs. Nat.

1st 24 hrs. after shot

Gas Cu. Ft.

Dry Hole

Abandoned

Date

11-28-33 P. J. Mammuch Scout

Rice

KANSAS

Map No. 46 Sec. 21 Twp. 20 R. 10WWell No. 3 West

Texas

Company

Contractor

FIRST REPORT

SECTION PLAT

NE NW NW

330 Ft. from N. Line

Ft. from S. Line

Ft. from E. Line

810 Ft. from W. Line

0			

RAYMOND POOL

Location

Rig up

Drilling and Remarks:

OWDD

Kansas City 3047

T.D. 3132

Fishing 3180

RECORD

Cased _____ in., _____ ft.

Sand _____

Gas _____

Oil _____

Total Depth _____

PRODUCTION

1st 24 hrs. Nat. _____

1st 24 hrs. after shot _____

Gas _____ Cu. Ft.

Dry Hole _____

Abandoned _____

Date

MAY 24 1939 19

S. J. LEWIS

Scout

Rice

KANSAS

Map No. _____ Sec. 21 Twp. 20 R. 10WWell No. 3 West

Texas

Company _____

Contractor _____

COMPLETE

NE NW NW

330 Ft. from N. Line

_____ Ft. from S. Line

_____ Ft. from E. Line

910 Ft. from W. Line

RAYMOND POOL

SECTION PLAT

0			

Location _____

Rig up _____

Drilling and Remarks:

*Per 83342.**7" @ 327.7**76' of 5" liner 3346**Pump 85 Ps Y*

RECORD

Cased _____ in., _____ ft.

Sand _____

Gas _____

Oil _____

Total Depth 3346

PRODUCTION

1st 24 hrs. Nat. _____

1st 24 hrs. after shot _____

Gas _____ Cu. Ft.

Dry Hole _____

Abandoned _____

Date

JUN 21 1939S. J. LEWIS

Scout