


Section 18 Township 18 Range 6W

Well No. #5 Brinkerhoff

Company Sun Oil

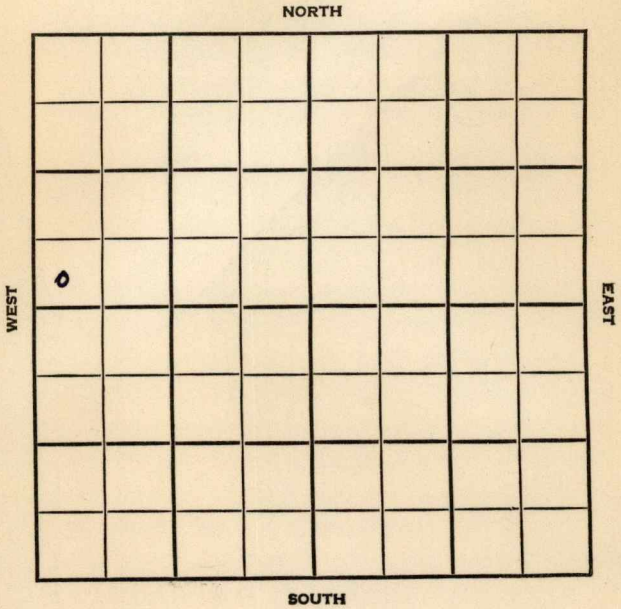

Rice

KANSAS

SEC. 18	TWP. 18	R. 6W
------------	------------	----------


WELL NO. #5 Brinkerhoff FARM

COMPANY Sun Oil

CONTRACTOR Capitt Drlg.

Crawford Pool

\_\_\_\_\_ Ft. from N. Line  
 330 \_\_\_\_\_ Ft. from S. Line  
 \_\_\_\_\_ Ft. from E. Line  
 330 \_\_\_\_\_ Ft. from W. Line

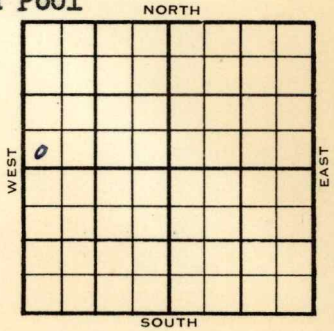

SW SW NW

1954	ELEVATION 1693'	REPORT
------	--------------------	--------

9/1 Location  
 9/22 Abandoned Location

**ABANDONED**



