

5M-5-34-Pala  
KANSAS  
-----

WEST

# EAST

## SOUTH

Rig Up\_\_\_\_\_

### Drilling Remarks

## PRODUCTION

1st 24 hrs. Nat.-----

1st 24 hrs. after shot-----

Gas \_\_\_\_\_ cu. ft. \_\_\_\_\_

Dry Hole.....


Abandoned-----

*Rice*

Map No. KANSAS Sec. 21 Twp. 20 R. 10 W

Well No. 4 Metzger Farm  
Phillips Pet. Company

990 Ft. from N. Line  
  
         Ft. from S. Line  
  
         Ft. from E. Line  
  
330 Ft. from W. Line

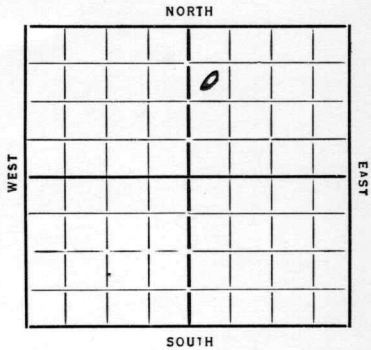

Date 7/29/41

REPORT

|               |                                                                 |                  |
|---------------|-----------------------------------------------------------------|------------------|
| <u>1/4/36</u> | <u>Location</u>                                                 |                  |
| <u>1/3/35</u> | <u>Bldg</u>                                                     |                  |
| <u>1/1/0</u>  | <u>Rgn</u>                                                      |                  |
| <u>1/1/7</u>  | <u>Alg 275</u>                                                  | <u>20" 96</u>    |
| <u>1/2/4</u>  | <u>" 890</u>                                                    | <u>15" 453</u>   |
| <u>1/3/1</u>  | <u>" 1600</u>                                                   | <u>Salt 970</u>  |
| <u>2/7</u>    | <u>" 1945</u>                                                   |                  |
| <u>2/14</u>   | <u>" 2555</u>                                                   | <u>10" 2145</u>  |
|               | <u>S.O. &amp; G 2230</u>                                        | <u>S.O. 2345</u> |
| <u>7/21</u>   | <u>Alg 2850</u>                                                 | <u>8" 2601</u>   |
| <u>7/28</u>   | <u>" 3062</u>                                                   |                  |
| <u>3/7</u>    | <u>U.R. 8"</u>                                                  |                  |
| <u>3/14</u>   | <u>Sil <sup>3340</sup> <del>3325</del> T 17 3323 1/2 Cum 6"</u> |                  |
| <u>3/21</u>   | <u>Sil 3340 Corrected P.B.P.</u>                                |                  |
| <u>3/28</u>   | <u>3345 T 17 1700' oil</u>                                      |                  |
| <u>4/3</u>    | <u>Siliceous 3340 T 17 3345</u>                                 |                  |
|               | <u>315 Bbls.</u>                                                |                  |

COMPLETED

KANSAS

Map No. 46 Sec. 21 Twp. 20 R. 10W

Well No. 4 Metzger

Phillips pet Company

Contractor

SECTION PLAT

FIRST REPORTS

990 Ft. from N. Line

..... Ft. from S. Line

..... Ft. from E. Line

330 Ft. from W. Line

|  |  |   |  |
|--|--|---|--|
|  |  |   |  |
|  |  | 0 |  |
|  |  |   |  |
|  |  |   |  |
|  |  |   |  |
|  |  |   |  |

Location ☒

Rig up ☒

Drilling and Remarks:

RECORD

Cased.....in., .....ft.

Sand.....

Gas.....

Oil.....

Total Depth.....

PRODUCTION

1st 24 hrs. Nat.....

1st 24 hrs. after shot.....

Gas.....Cu. Ft.

Dry Hole.....

Abandoned.....

Date

12-26-34 192

ORVAL MANNSCHRECK

Scout

KANSAS

Map No. 46 Sec. 21 Twp. 20 R. 10W

Well No. 4-Mitger

Phillips pet Company

Contractor

COMPLETED

SECTION PLAT

990 Ft. from N. Line

Ft. from S. Line

Ft. from E. Line

330 Ft. from W. Line

|   |  |   |  |
|---|--|---|--|
|   |  |   |  |
|   |  | 0 |  |
|   |  |   |  |
| 5 |  |   |  |
|   |  |   |  |

Location

Rig up

Drilling and Remarks:

315 Hb

RECORD

Cased in, ft.

Sand silicious 3340

Gas

Oil

Total Depth 3345

PRODUCTION

1st 24 hrs. Nat.

1st 24 hrs. after shot

Gas Cu. Ft.

Dry Hole

Abandoned

Date

4-3-35 192

ORVAL MANNSCHRECK

Scout