
KANSAS

DX 78-1 RICE

Section 19 Township 18 Range 6W

Well No. 1 Habiger

Company Schafer & Riggs

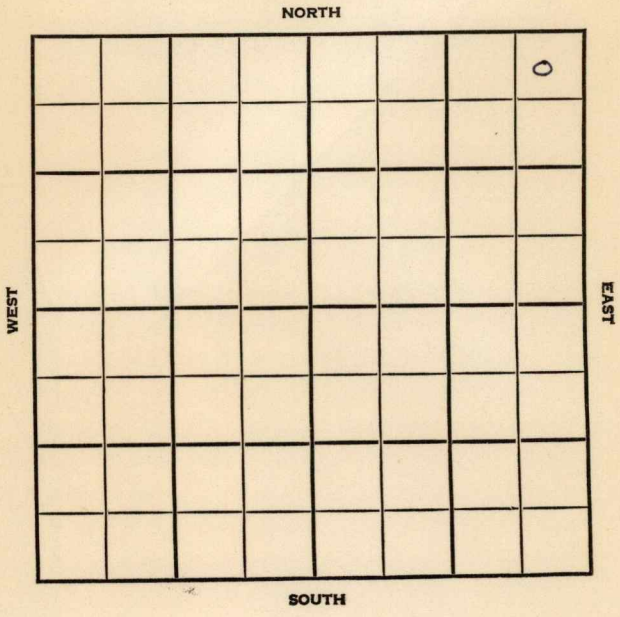

Rice KANSAS

SEC.	TWP.	R.
19	18	6W

WELL NO.

1 Habiger FARM

COMPANY

Schafer & Riggs

CONTRACTOR

Schafer


330 Ft. from N. Line

Ft. from S. Line

330 Ft. from E. Line

Ft. from W. Line

NE NE NE

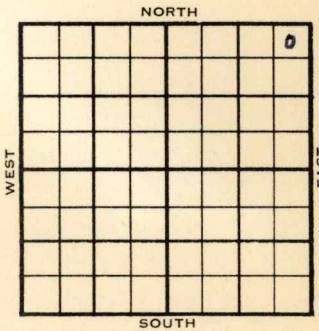

1955	ELEVATION 1678'	REPORT

3/30 Location

7/13 Comm. 3-30-55
8-5/8" @ 147/100 5" @ 3217
DD 3310' PB 3221 ffac.
FU 700' oil SSW 12 hr.
S/2 BOPH P/25 BOPD 10% wtr.
Comp. 25 BOPD 10% wtr.
H. 2590', Tr. 2618', sd 2647',
BL 2715', L. 2756' C. 3214'
TD 3222'

COMPLETED

DX-78

FORM 275 FOR SALE BY KANSAS BLUE PRINT CO.


County Rice State Kansas

Sec. 19 (Blk. / Twp.) 18 (Sur. / Rge.) 6W Map No.

Operator Schafer & Riggs

Well No. 1 Farm Habiger

Elev. Location NE NE NE

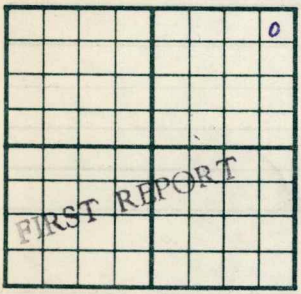

330 Ft. From N Line NE

330 Ft. From E Line Quarter

1st. Report MAR 30 1955

Completion

Remarks

Schafer - Contr.

Spudding Date

Drlg. Data

Location

FABEN GILSTRAP

FORM 513 REV. SUNRAY

County Rice Elev. 1678

Sec. 19 Twp. 18 Rge. 6W

Company Schafer & Riggs

Farm Name Habiger No. 1

TOPS	DEPTH	LOG	DATUM
Anh.			
Tp.			
H.	2590		912
Tr.	2618		940
Dg. sd.	2647		969
B.L.	2714		1037
L.	2756		1078
K.C.			
B.K.C.			
Ce.			
C.	3214		1536
M.			
M.			
K.			
Mz.			
Mo.			
V.			
S.			
S.			
A			
R.			
P€.			
G.			
T.D.	3222		

Loc. in Sec. NE NE NE

Geol.

Contr. Schafer

Pool SE CRawford



Date Comm. 3-30-55 JUL 13 1955

8 5/8" @ 147/100 5" @ 3217 DD 3310

PB 3221 frac FU 700' oil SSW 12 hr.

S/ 2 boph P/ 25 bopd 10% wtr.

Comp. 25 bopd 10% wtr.

Co. Lse. No. Sec. T. R.