


Rice

Form 51-5M-11-31-Palace

Map No. _____ Sec. *21* Twp. *20* R. *10W*

Well No. *4 Schurr* Farm
Slick, Pryor + Lockhart Company

NORTH

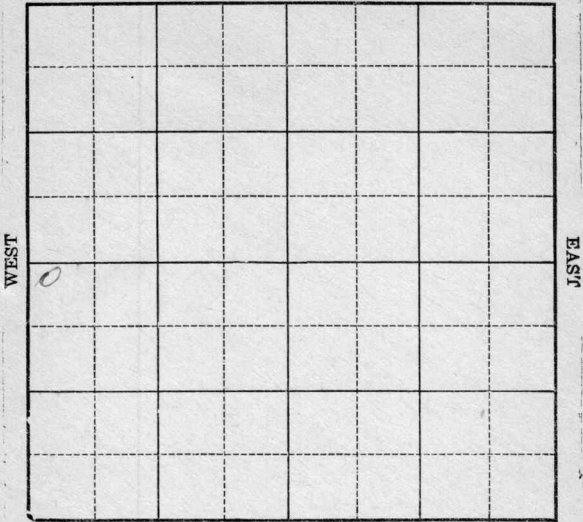

Location _____

Drilling Remarks _____

Rig Up _____

Drilling Remarks _____

RECORD

Cased _____ in. _____ ft.

Sand _____

Gas _____

Oil _____

Total Depth _____

PRODUCTION

1st 24 hrs. Nat. _____

1st 24 hrs. after shot _____

Gas _____ cu. ft.

Dry Hole _____

Abandoned _____

Map No. _____ Sec. 21 Twp. 20 R. 10W

Well No. #4 Schurr Farm


Slick, Pryor, Lockhart Company

330 Ft. from N. Line

_____ Ft. from S. Line

_____ Ft. from E. Line

330 Ft. from W. Line

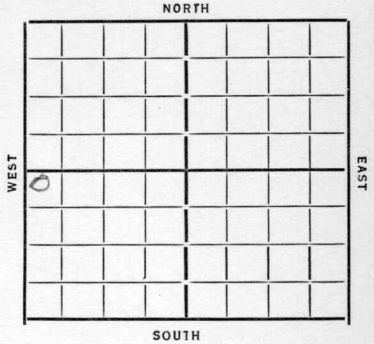

Date 1933

REPORT

- 7/19 location
- 7/26 Bldg Rig
- 8/2 Rig in op
- 8/9 20" - 64 - 15" 423' 13" 877 dily 940'
- 8/17 dily 2110'
- 8/23 10" 2101 N.7.W 2560 - 75 8" 2578
- 8/30 8" 2977 - 3150 fig.
- 9/6 dreg 3245
- 9/13 2op Sil 3317 - TAD 3329 - 2300' oil
- 9/20 Siliceous 3317
- T. D. 3329
- 1198 bbls (potential)

COMPLETED

KANSAS

Map No. 46 Sec. 21 Twp. 20 R. 10W

Well No. #4 - Schurr

Slick, Pryor & Lockhart Company

Contractor

SECTION PLAT

330 Ft. from N. Line

..... Ft. from S. Line

..... Ft. from E. Line

330 Ft. from W. Line

0			

FIRST REPORTS

Location ✓

Rig up

Drilling and Remarks:

RECORD

Cased..... in., ft.

Sand.....

Gas.....

Oil.....

Total Depth.....

PRODUCTION

1st 24 hrs. Nat.....

1st 24 hrs. after shot.....

Gas..... Cu. Ft.

Dry Hole.....

Abandoned.....

Date

7/19/33 192 Oval Mannesbach Scout

Map No. 46 Sec. 21 Twp. 20 R. 10W

Well No. H Schur

Slick property I. Company

Contractor

SECTION PLAT

330 Ft. from N. Line

Ft. from S. Line

Ft. from E. Line

330 Ft. from W. Line

0			

COMPLETED

Location.....

Rig up.....

Drilling and Remarks:

1198 bbls potential

RECORD

Cased..... in., ft.

Sand blue mus 5317

Gas.....

Oil.....

Total Depth 3329

PRODUCTION

1st 24 hrs. Nat.....

1st 24 hrs. after shot.....

Gas..... Cu. Ft.

Dry Hole.....

Abandoned.....

Date

9/20/33 O. Mannschreck Scout