


Rice

Form 51—5M—5-34—Palace

Map No. KANSAS Sec. 21 Twp. 20 R. 10^W

Well No. 5 West Farm
Thyer Co. Company

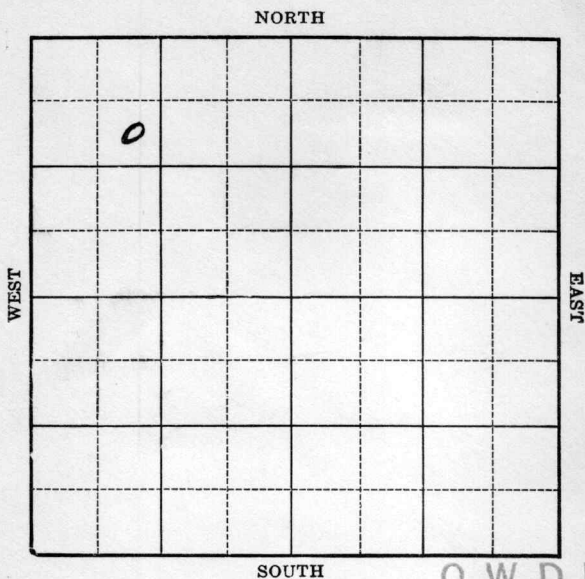

Location _____

Drilling Remarks _____

Rig Up _____

Drilling Remarks _____

RECORD

Cased _____ in. _____ ft.

Sand _____

Gas _____

Oil _____

Total Depth _____

PRODUCTION

1st 24 hrs. Nat. _____

1st 24 hrs. after shot _____

Gas _____ cu. ft.

Dry Hole _____


Abandoned _____

Rice

Map No. KANSAS Sec. 21 Twp. 20 R. 10^W

Well No. 5 West Farm _____
Lynn Co. Company _____

990 Ft. from N. Line
____ Ft. from S. Line
____ Ft. from E. Line
990 Ft. from W. Line

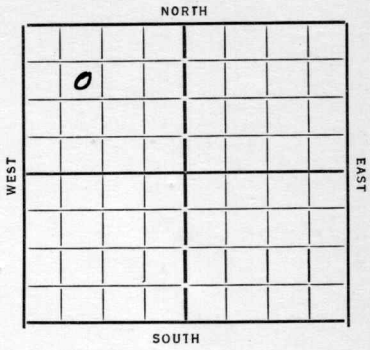

Date 1934

REPORT O. W. D. D

8/1	Location
8/9	Bldg Rig
8/16	Spud
8/23	Dlg 2040 12" 134
8/30	" 3070
9/6	KCL 3040 8" 3090
	TD 3115 Rust
9/13	Bailing
9/20	3142-48 with 5" liner
	260' at 3245 Silicious 3331
	TD 3341 2500' oil
9/27	Shut 735 Bbls 24 hrs.
	Acidizing
10/3	Silicious 3331 TD 3341
	1000 acid 972 Bbls.

COMPLETED

OVER

O. W. D. D

1938

7/6 Old T. D. 3341'.

R. U.

Will deepen for a salt water disposal well.

7/15 " " "

7/22 Dlg. 3794'.

7/29 Sand 3944-58'.

Granite 3958-60' T.D.

Rng. 5" - 3517'.

8/5 " " "

8/10 Sand 3944-58'.

Granite 3958-60'.

T. D. 3960'.

402' of 5" set 3094-3496'.

INPUT:

250 barrels water per hour on pump.

ABANDONED

KANSAS

Map No. 46 Sec. 21 Twp. 20 R. 10^W

Well No. 5- West

Texas Co

Company

Contractor

FIRST REPORTS

SECTION PLAT

0			

990 Ft. from N. Line

_____ Ft. from S. Line

_____ Ft. from E. Line

990 Ft. from W. Line

Location ✓

RECORD

Cased _____ in., _____ ft.

Sand _____

Gas _____

Oil _____

Total Depth _____

PRODUCTION

1st 24 hrs. Nat. _____

1st 24 hrs. after shot _____

Gas _____ Cu. Ft.

Dry Hole _____

Abandoned _____

Rig up _____

Drilling and Remarks:

Date

8-1-34

19

ORVAL MANN SCHRECK

Scout

Map No. 46 Sec. 21 Twp. 20 R. 10W

Well No. 5- West

Texas Company Company

Contractor

COMPLETED

SECTION PLAT

990 Ft. from N. Line

..... Ft. from S. Line

..... Ft. from E. Line

990 Ft. from W. Line

0			

Location.....

Rig up.....

Drilling and Remarks:

1000 acid

972 bbls

RECORD

Cased..... in., ... ft.

Sand siliceous 3331

Gas.....

Oil.....

Total Depth 3341

PRODUCTION

1st 24 hrs. Nat.....

1st 24 hrs. after shot.....

Gas..... Cu. Ft.

Dry Hole.....

Abandoned.....

Date

ORVAL MANNSCHRECK

10-3-34 192.....

Scout

Map No. 46 Sec. 21 Twp. 20 R. 10WWell No. 5 WestTexas

Company _____

Contractor _____

FIRST REPORT
SE NW NW

SECTION PLAT

990 Ft. from N. Line

_____ Ft. from S. Line

_____ Ft. from E. Line

990 Ft. from W. Line

0			

Location _____

RECORD

Cased _____ in., _____ ft.

Sand _____

Gas _____

Oil _____

Total Depth _____

PRODUCTION

1st 24 hrs. Nat. _____

1st 24 hrs. after shot _____

Gas _____ Cu. Ft.

Dry Hole _____

Abandoned _____

Drilling and Remarks:

RU.

OWDD OTD 3341
will deepen for
S.W.D.

Date

JUL 6 - 1938

19

H. D. Hatfield Scout

Rice

KANSAS

Map No. 46 Sec. 21 Twp. 20 R. 10WWell No. 5 WestTexas

Company _____

Contractor _____

COMPLETED**SE NW NW**990 Ft. from N. Line

_____ Ft. from S. Line

_____ Ft. from E. Line

990 Ft. from W. Line**SECTION PLAT**

0			

Location _____

RECORD

Cased _____ in., _____ ft.

Sand 3944-58Gas GRANITE 3958-60

Oil _____

Total Depth 3960**PRODUCTION**

1st 24 hrs. Nat. _____

1st 24 hrs. after shot _____

Gas _____ Cu. Ft.

Dry Hole _____

Abandoned _____

Drilling and Remarks:

OWDD For S.W.D.402' of 5" set3094-3496INPUT:250 bbls wtr P.H.on pump

Date

AUG 10 1938 19H. D. Hatfield Scout