


Rice

Map No. KANSAS Sec. 21 Twp. 20 R. 10^W

Well No. 6 Schurr Farm
Slick, Pryor & Lockhart Company

990 Ft. from N. Line
____ Ft. from S. Line
____ Ft. from E. Line
330 Ft. from W. Line

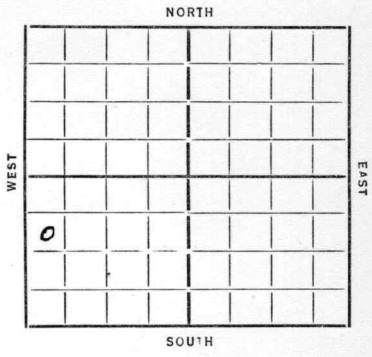

| Date | REPORT |
|-------|------------------------------------------------------------|
| 9/19 | Rig |
| 9/27 | Regru up |
| 10/4 | Dly 845 15" 240 |
| 10/11 | 13" 860 A.M. 1415 A.M. 1500 Dly 1805 |
| 10/18 | 10" 1865 2025 W.R. 10" |
| 10/25 | A.O. 2155-70 A.M. 2250-60 Dly 2460 |
| 11/1 | " 3000 H.F.W. 2530-40 |
| 11/8 | 6" 3223 Cong. 3260 T.D. 3295 Peg 3290-95 H.F.O. 12 hrs. |
| 11/15 | 6" 3292 Sil 3295 T.D. 3296 H.F.O. |
| 11/22 | T.D. 3300 Pump 150 oil & 60 W 24 hrs. |
| 11/27 | Siliceous 3295 T.D. 3300 370 oil 200 Water |
| | COMPLETED |

Map No. 46 Sec. 21 Twp. 20 R. 10W

Well No. 6-Schurr

Slick, Pryor, & Forkhart Company

Contractor

SECTION PLAT

| | | | |
|---|--|--|--|
| | | | |
| | | | |
| 0 | | | |
| | | | |

990 Ft. from N. Line

_____ Ft. from S. Line

_____ Ft. from E. Line

330 Ft. from W. Line

FIRST REPORTS

Location _____

Rig up _____

Drilling and Remarks:

Rig

RECORD

Cased _____ in., _____ ft.

Sand _____

Gas _____

Oil _____

Total Depth _____

PRODUCTION

1st 24 hrs. Nat. _____

1st 24 hrs. after shot _____

Gas _____ Cu. Ft.

Dry Hole _____

Abandoned _____

Date

9-19-37 19

ORVAL MANNSCHRECK Scout

Map No. 46 Sec. 21 Twp. 20 R. 10W

Well No. 6-Schurr

Slick p & t Company

Contractor

COMPLETED

SECTION PLAT

990 Ft. from N. Line

..... Ft. from S. Line

..... Ft. from E. Line

330 Ft. from W. Line

| | | | |
|--|--|--|--|
| | | | |
| | | | |
| | | | |
| | | | |
| | | | |

Location

Rig up

Drilling and Remarks:

370 oil
200 water

RECORD

Cased in., ft.

Sand Schurr 329.5

Gas

Oil

Total Depth 3300

PRODUCTION

1st 24 hrs. Nat.

1st 24 hrs. after shot

Gas Cu. Ft.

Dry Hole

Abandoned

Date

11-27-34 192

ORVAL MANNSCHRECK

Scout