


Map No. KANSAS Sec. 21 Twp. 20 R. 10^w
 Well No. 6 West Farm _____
Super Co. Company _____

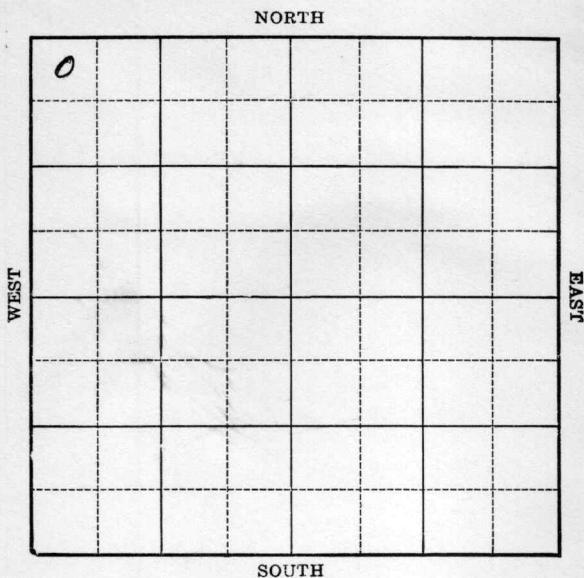

Location _____

Drilling Remarks _____

RECORD

Cased _____ in. _____ ft.

Sand _____

Gas _____

Oil _____

Total Depth _____

Rig Up _____

Drilling Remarks _____

PRODUCTION

1st 24 hrs. Nat. _____

1st 24 hrs. after shot _____

Gas _____ cu. ft. _____


Dry Hole _____

Abandoned _____

Rice

Map No. KANSAS Sec. 21 Twp. 20 R. 10 W
Well No. 6 West Farm
Lyons Co. Company

330 Ft. from N. Line
 Ft. from S. Line
 Ft. from E. Line
330 Ft. from W. Line

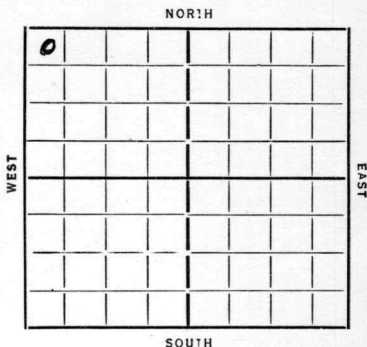

Date 1934

REPORT

8/22	Location	
8/30	Rgn up	
9/6	Dly 110	
9/13	" 177	12" 82
9/20	Dly 900	1110' PB 675
9/27	" 2057	
10/4	" 2809	
10/11	seg 2809	
10/18		
10/25	Dly 2945	
11/1	" 3045	as well 3030
11/8		
11/15	Dly 3275	
11/22	Dil 3343 T1 3344	
	1000 fluid 250 water	
11/28	3345 T1 65 oil 015 w.	
	24 hrs. Acidizing	
12/6	40 oil 60 w 24 hrs.	
12/12	Silicious 3343 T1 3344	
	1000 acid 49 oil 108 Water	

COMPLETED

Map No. 46 Sec. 21 Twp. 20 R. 10W

Well No. 6- West

Texas Co Company

Contractor

FIRST REPORTS

SECTION PLAT

330 Ft. from N. Line

_____ Ft. from S. Line

_____ Ft. from E. Line

330 Ft. from W. Line

0			

Location ✓

Rig up _____

Drilling and Remarks:

RECORD

Cased _____ in., _____ ft.

Sand _____

Gas _____

Oil _____

Total Depth _____

PRODUCTION

1st 24 hrs. Nat. _____

1st 24 hrs. after shot _____

Gas _____ Cu. Ft.

Dry Hole _____

Abandoned _____

Date

8-22-34 19

ORVAL MANNSCHRECK Scout

Map No. 46 Sec. 21 Twp. 20 R. 10WWell No. 6-WestTexas Company Company

Contractor

SECTION PLAT

COMPLETED

330 Ft. from N. Line

Ft. from S. Line

Ft. from E. Line

330 Ft. from W. Line

0			

Location

Rig up

Drilling and Remarks:

1000 acid49 oil
108 water

RECORD

Cased in., ft.

Sand Siliceous 3343

Gas

Oil

Total Depth 3344

PRODUCTION

1st 24 hrs. Nat.

1st 24 hrs. after shot

Gas Cu. Ft.

Dry Hole

Abandoned

Date

ORVAL MANNSCHRECK

12-23 192

Scout