


Map No. KANSAS Sec. 21 Twp. 20 R. 10W
 Well No. 7 West Farm _____
Teape Co Company _____

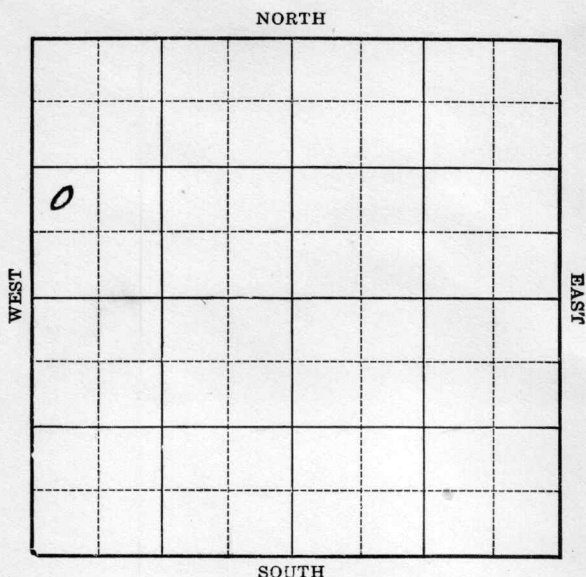

Location _____
 Drilling Remarks _____

Rig Up _____
 Drilling Remarks _____

RECORD

Cased _____ in. _____ ft.
 Sand _____
 Gas _____
 Oil _____
 Total Depth _____

PRODUCTION

1st 24 hrs. Nat. _____
 1st 24 hrs. after shot _____
 Gas _____ cu. ft.
 Dry Hole _____
 Abandoned _____

Rice


Map No. KANSAS Sec. 21 Twp. 20 R. 10^W
Well No. 7 West Farm _____
Texas Co. Company _____

_____ Ft. from N. Line

990 Ft. from S. Line

_____ Ft. from E. Line

330 Ft. from W. Line

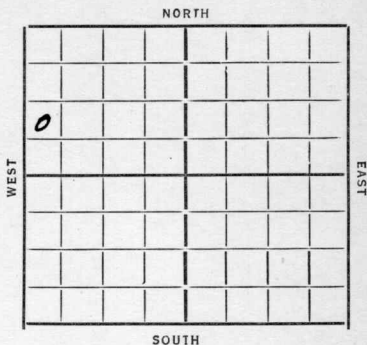

Date 1934

REPORT

10/10 Motored
10/18 — 10/25 —
11/1 Rign Rotary
11/8 Sly 1312 12" 130
11/15 2356 Rep. Motor
11/22 Sly 3195 K.C. 3040
11/28 Siliceous 3326 7" 3326
12/6 Rust
12/12 Siliceous 3326 TD 3334
522 Bbls oil 3% Water.

COMPLETED

KANSAS

Map No. 46 Sec. 21 Twp. 20 R. 10WWell No. 7 - WestTexas Co

Company

Contractor

FIRST REPORTS

SECTION PLAT

0			

_____ Ft. from N. Line

990 Ft. from S. Line

_____ Ft. from E. Line

330 Ft. from W. Line

Location _____

Rig up _____

Drilling and Remarks:

material

RECORD

Cased _____ in., _____ ft.

Sand _____

Gas _____

Oil _____

Total Depth _____

PRODUCTION

1st 24 hrs. Nat. _____

1st 24 hrs. after shot _____

Gas _____ Cu. Ft.

Dry Hole _____

Abandoned _____

Date

10-10-34 19

ORVAL MANNSCHRECK

Scout

Map No. 46 Sec. 21 Twp. 20 R. 10WWell No. 7-WestTexas Company Company

Contractor

COMPLETED

SECTION PLAT

0			
1			

Ft. from N. Line

990 Ft. from S. Line

Ft. from E. Line

330 Ft. from W. Line

Location

Rig up

Drilling and Remarks:

522 hpts oil
34% water

RECORD

Cased _____ in., _____ ft.

Sand siliceous 3326

Gas _____

Oil _____

Total Depth 3334

PRODUCTION

1st 24 hrs. Nat. _____

1st 24 hrs. after shot _____

Gas _____ Cu. Ft.

Dry Hole _____

Abandoned _____

Date

12-12-34 192

ORVAL MANNSCHRECK

Scout