


Map No. Price KANSAS Sec. 22 Twp. 20 R. 10

Well No. 1-Loesch Farm

Natlock et al Company

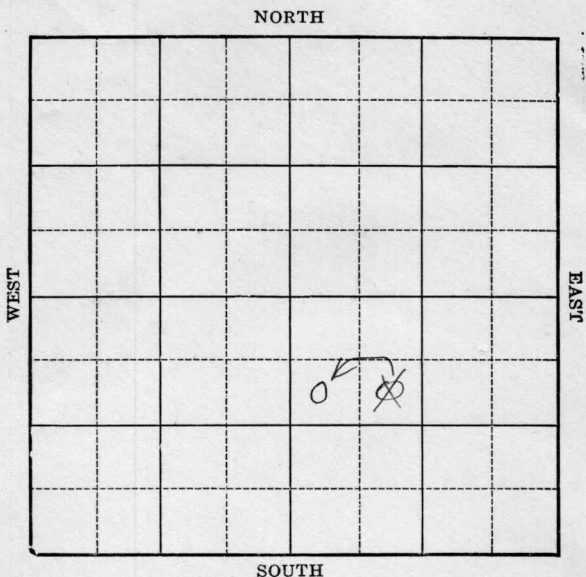

1802

Location _____
Drilling Remarks _____

Rig Up _____
Drilling Remarks _____

RECORD

Cased _____ in. _____ ft.
Sand _____
Gas _____
Oil _____
Total Depth _____

PRODUCTION

1st 24 hrs. Nat. _____
1st 24 hrs. after shot _____
Gas _____ cu. ft.
Dry Hole _____
Abandoned _____

Map No. KANSAS Sec. 22 Twp. 20 R. 10^w
 Well No. 1-Loesch Farm
Watlock et al Company

NORTH

WEST

EAST

SOUTH

990 Ft. from N. Line

_____ Ft. from S. Line

_____ Ft. from E. Line

330
~~990~~ Ft. from W. Line

1930

Date

REPORT

3/26	Loc
4/2	Bldg rig
4/9	Spud
4/16	Driving 20"
4/23	15"- 400 Sg. out
4/30	1165 seg. bails
5/7	Relg. 1300'
5/14	" 1340'
5/21	Run 8"- 1885'
5/28	Relg. 2140'
6/4	77W. 2330'
	T.D. 2345' U.R. 8"
6/11	U/R 8"- 2610'
6/18	Relg. 2840'
6/25	8"- 2784'
	T.D. 2840' S.D.
7/2	— 8/6 —
7/9	— 8/13 —
7/16	— 8/20 — (over)
7/23	— 8/27 —
7/30	— 9/3 —
	9/10 —

9/17- Drlg 2965'

9/24- UPR 6"- 3282'

10/1- Top Conglomerate

3334'- HFW 3341-50

6"- 3353' Drlg. 3385'

10/8- Top Silc lime 3402

HFW

TD 3403

Abandon

Map No. KANSAS Sec. 22 Twp. 20 R. 10 W

Well No. 1 Loesch

Tatlock & Co Company

Contractor

SECTION PLAT

		0	

990 Ft. from N. Line

..... Ft. from S. Line

..... Ft. from E. Line

990 Ft. from W. Line

FIRST REPORTS

Location ✓

Rig up

Drilling and Remarks:

RECORD

Cased.....in., ...ft.

Sand

Gas

Oil

Total Depth.....

PRODUCTION

1st 24 hrs. Nat.....

1st 24 hrs. after shot.....

Gas.....Cu. Ft.

Dry Hole.....

Abandoned.....

Date

MAR 26 1930

192

S. J. LEWIS

Scout

Map No. KANSAS Sec. 22 Twp. 20 R. 10W

Well No. Loesch

Haddock & Co Company

Contractor

SECTION PLAT

990 Ft. from N. Line

..... Ft. from S. Line

..... Ft. from E. Line

830 Ft. from W. Line

		0	

CORRECTION

Location.....

Rig up.....

Drilling and Remarks:

*Reported
BEVNSE*

RECORD

Cased.....in., ...ft.

Sand.....

Gas.....

Oil.....

Total Depth.....

PRODUCTION

1st 24 hrs. Nat.....

1st 24 hrs. after shot.....

Gas.....Cu. Ft.

Dry Hole.....

Abandoned.....

Date

MAY 7 1930

192.....

S. J. LEWIS Scout

Map No. KANSAS Sec. 22 Twp. 20 R. 10 W

Well No. 1 Loesch

Tatlock & Dal Company

Contractor

SECTION PLAT

990 Ft. from N. Line

_____ Ft. from S. Line

_____ Ft. from E. Line

330 Ft. from W. Line

ABANDONED

		0	

Location _____

Rig up _____

Drilling and Remarks:

Top of oil here
3402. NFW

RECORD

Cased _____ in., _____ ft.

Sand _____

Gas _____

Oil _____

Total Depth 3403

PRODUCTION

1st 24 hrs. Nat. _____

1st 24 hrs. after shot _____

Gas _____ Cu. Ft.

Dry Hole _____

Abandoned _____

Date

OCT 8 1930

S. J. LEWIS

Scout