


Section 24 Township 20 Range 10-W

Well Number 1 Leming

Company Winkler-Dnock Royalty et al

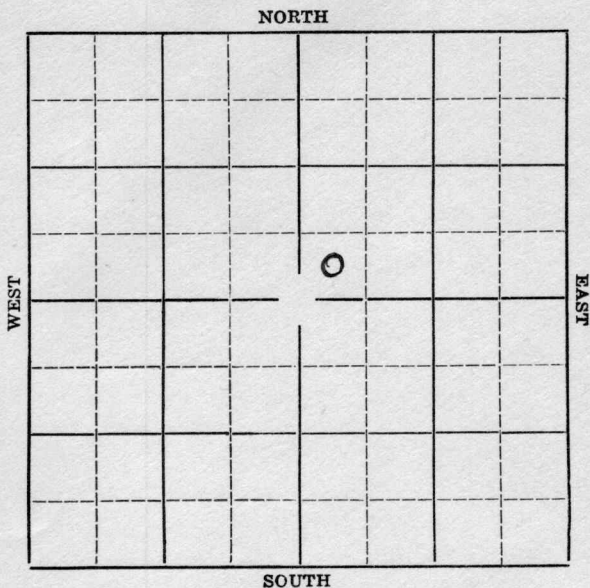

Sec. 24 Twp. 20 R. 10-W

Well No. #1 Leming Farm


Winkler-Knock Royalty et al Company

_____ Ft. from N. Line

330 Ft. from S. Line

_____ Ft. from E. Line

330 Ft. from W. Line

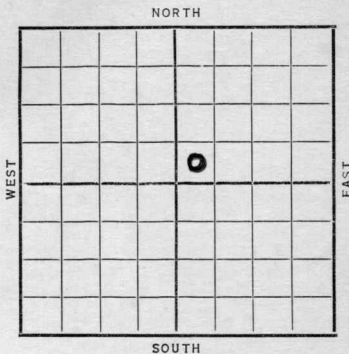

Date	REPORT
1937	
3/10	Rig
3/18	12" @ 155 Drlg. 2485'
3/25	KCL 3034'. Conglomerate 3280'. Coring 3409'.
3/31	Sil. 3389'. T.D. 3440'. Water.
	COMPLETED

Rice

Map No. _____ Sec. 24 Twp. 20 R. 10W.

Well No. 1 Leming

Winkler-Huck Royalty et al Company
Contractor

SECTION PLAT

		0	

_____ Ft. from N. Line

320 Ft. from S. Line

_____ Ft. from E. Line

330 Ft. from W. Line

FIRST REPORT

Location _____

Rig up _____

Drilling and Remarks:

Rig

RECORD

Cased _____ in., _____ ft.

Sand _____

Gas _____

Oil _____

Total Depth _____

PRODUCTION

1st 24 hrs. Nat. _____

1st 24 hrs. after shot _____

Gas _____ Cu. Ft.

Dry Hole _____

Abandoned _____

Date

MAR 10 1937 19

S. J. LEWIS Scout

KANSAS *Rice*

Map No. _____ Sec. 24 Twp. 20 R. 10W

Well No. 1 Leming

Hinkler, Roda Royalty Company
Contractor

SECTION PLAT

		0	

_____ Ft. from N. Line

330 Ft. from S. Line

_____ Ft. from E. Line

330 Ft. from W. Line

ABANDONED

Location _____

Rig up _____

Drilling and Remarks:

Sil 3389

Water

RECORD

Cased _____ in., _____ ft.

Sand _____

Gas _____

Oil _____

Total Depth 3440

PRODUCTION

1st 24 hrs. Nat. _____

1st 24 hrs. after shot _____

Gas _____ Cu. Ft.

Dry Hole

Abandoned

Date

MAR 31 1937

19

S. J. LEWIS Scout