


Section 1 Township 17 Range 15WWell No. #1 Heuny (Hejny)Company Richard King, Jr., (McAllen, Tex.)

NORTH

WEST

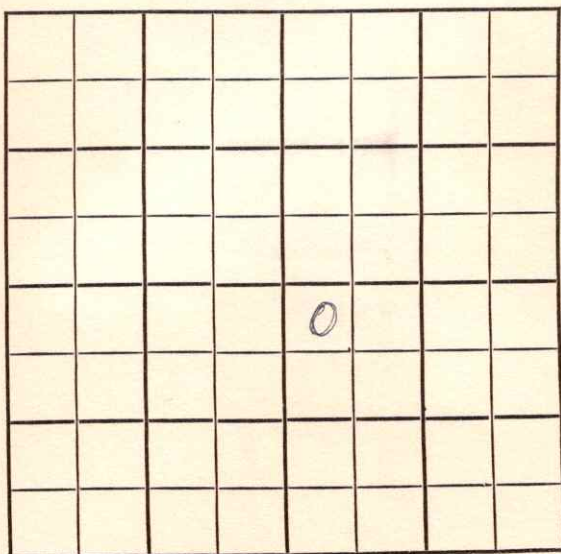

EAST

SOUTH

Co.

County Barton Elev. 1977
 Sec. 1 Twp. 17 Rge. 15W
 Company Richard King Jr. (McAllen, Tex.)
 Farm Name Heuny (Hejny) No. 1

TOPS	DEPTH	LOG	DATUM	Loc. in Sec.
Anh.	275			NW NW SE
TP.				
H.	3159			
Tr.	3126			
Dg.				
Bl.				
L.	3225			Geol. Chase
K.C.				Contr.
B.K.C.				Bennett & Ro
Ce.				bert Tools
C.				Pool Leoville
M.				Wildcat
M.				
K.				
Mz.				
Mo.				
V.				
S.				
S.				
A.	3468			
R.				
Pe.				
G.				
T.D.	3472			

Geol. Chase
 Contr.
 Bennett & Ro
 bert Tools
 Pool Leoville
 Wildcat

COMPLETE
 JAN 16 '57

Sec.

No.

Sec.

T.

R.

Date Comm.

CRA (FO)

B & B supp. NOV 23 '56 11-20-56

8 5/8 340 1200 ID 3030 DEC 5 '56

DST 3394-3400 1hr rec 100'

SW BHP 1200 DST 3454-69

Failed DST 3446-69 1hr rec

20' Md BHP 0 DST 3445-72

up 1hr rec 300' oil + 365' GEMCO

FP 140-305 BHP 1025 5 1/2

3469 1/2 DEC 12 '56 CO 3472 TD

FU 1200 oil no/w \$ 13 1/2
 Boph no/w 2 hrs 600' 0.8
 \$ 13 1/2 Boph no/w 2 hrs
 500 0.8 TQR DEC 19 '55 P. 3 1/2
 Boph no/w tr. DEC 26 '56 P.
 79 Bo no/w tr 24 hrs JAN 2 '57
 JAN 9 '57 JAN 15 '57 PH P 178 Bopd
 570 wtr 9 raw 33°

WILDCAT

FORM 513 SUNRAY

County	Barton			Elev.	
Sec.	1	Twp.	17	Rge.	15W
Company	Richard King Jr. (McAllen, Tex.)				
Farm Name	Heuny (Hejny)			No.	1

TOPS	DEPTH	LOG	DATUM	Loc. in Sec.
Anh.				NW NW SE
Tr.				
H.				
Tr.				
Dg.				
Bl.				
L.				Geol. Chase
K.C.				Contr.
B.K.C.				Bennett & Robert Tools
Ce.				Pool
C.				Wildecatt
M.				
M.				
K.				
Mz.				
Mq.				
V.				
S.				
S.				
A.				
R.				
Pe.				
G.				
T.D.				

FIRST REPORT	
NOV 21 56	

Date Comm. CRA (FO)

B & B supp.

15