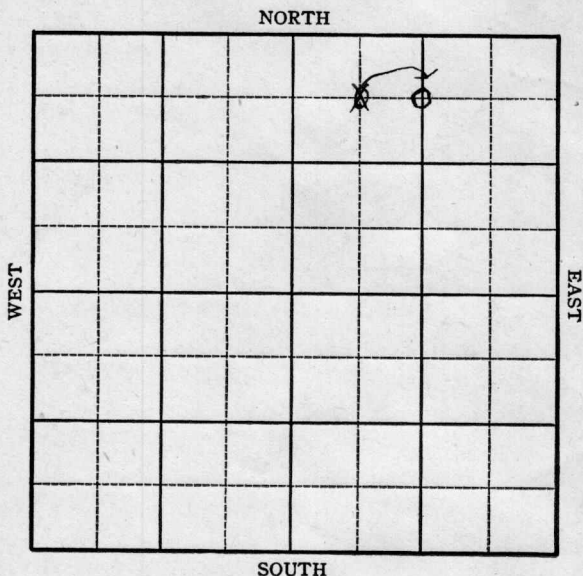


KANSAS

Rice

Section 26 Township 20 Range 10-WWell No. #1 LoeschCompany E.C.W.Hyde, Jr.

KANSAS

Rice County

Sec. 26 Twp. 20 R. 10W

Well No. #1 Loesch Farm

F. C. W. Hyde, Jr. Company


Silica

660 Ft. from N. Line

 Ft. from S. Line

1320 Ft. from E. Line

 Ft. from W. Line

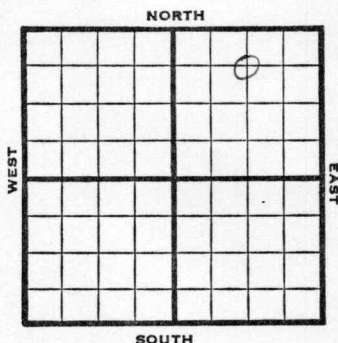

C N/2 NE

1945

Elev. 1792

REPORT

12/19

Location

12/29

"

1946

1/9

Lans. 3030

Arb. 3397

TD 3405'

ABANDONED

KANSASKansas Pool Name SilicaMap No. R-46 Sec. 26 Twp. 20 R. 10WWell No. 1 LoeschE. C. W. Hyde, Jr. CompanyFIRST REPORT Contractor

C NW NE

SECTION PLAT

660 Ft. from N. Line Ft. from S. Line Ft. from E. Line660 Ft. from W. Line

		0	

Rice CountyLocation XRig up

Drilling and Remarks:

RECORD

Cased in., ft.Sand Gas Oil Total Depth

PRODUCTION

1st 24 hrs. Nat. 1st 24 hrs. after shot Gas Cu. Ft.Dry Hole Abandoned

Date

DEC 19 1945

19

S. J. LEWIS

Scout

KANSAS

Kansas

Pool Name SilicaMap No. _____ Sec. 26 Twp. 20 R. 10WWell No. 1 LoeschF.C.W. Hyde, Jr. Company

CORRECTION

Contractor

C N $\frac{1}{2}$ NE

SECTION PLAT

660 Ft. from N. Line

_____ Ft. from S. Line

1320 Ft. from E. Line

_____ Ft. from W. Line

Rice County

Location _____

Rig up _____

Drilling and Remarks:

reported
C NW NE

RECORD

Cased _____ in., _____ ft.

Sand _____

Gas _____

Oil _____

Total Depth _____

PRODUCTION

1st 24 hrs. Nat. _____

1st 24 hrs. after shot _____

Gas _____ Cu. Ft.

Dry Hole _____

Abandoned _____

Date

DEC 28 1945

19

S. J. LEWIS


Scout

KANSAS

Kansas Pool Name SilicaMap No. 46 Sec. 26 Twp. 20 R. 10WWell No. 1 LoesckE. C. W. Hyde, Jr. Company

ABANDONED

Contractor

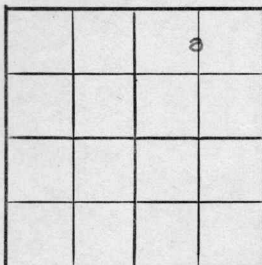C N $\frac{1}{2}$ NEE1.1792
SECTION PLAT660 Ft. from N. Line Ft. from S. Line1320 Ft. from E. Line Ft. from W. Line

Rice County

Location Rig up

Drilling and Remarks:

Lane 3000214397

RECORD

Cased in., ft.Sand Gas Oil Total Depth 3405

PRODUCTION

1st 24 hrs. Nat. 1st 24 hrs. after shot Gas Cu. Ft.Dry Hole Abandoned

Date

JAN 9 1946 19S. J. LEWIS Scout