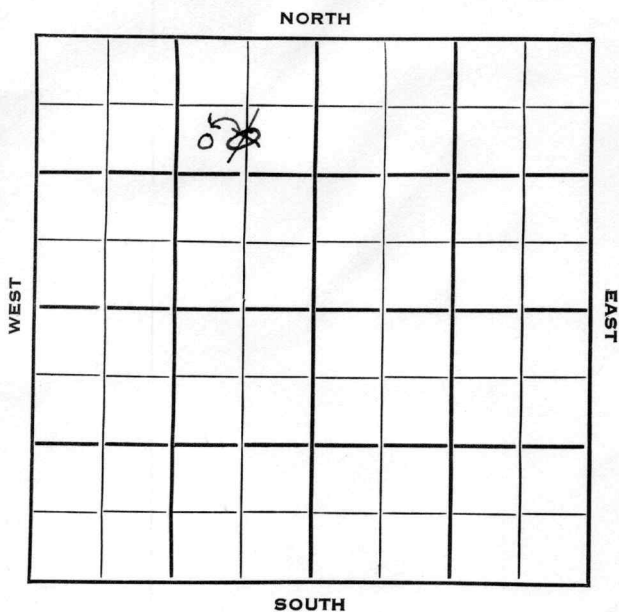


Section 22 Township 20 Range 10WWell No. #2 KellyCompany H. S. Herbel

Rice

KANSAS

Sec. 22 Twp. 20 R. 10WWell No. #2 Kelly FarmH. S. Herbel CompanyStagg Drlg. Contractor990 850 Ft. from N. Line


Ft. from S. Line

660 990 Ft. from E. Line

Ft. from W. Line

~~CS L NE NW~~

SW NE NW

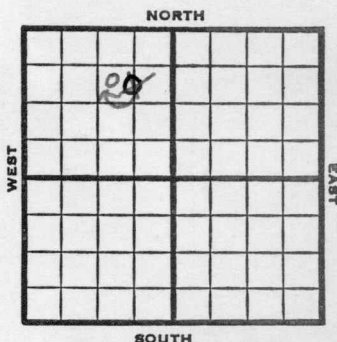

1953

Elev. 1840'

REPORT

7/29 RUR

8/5 8" @ 144 w/125 Anhy 480'

Heeb 2919'

Drlg. 3040'

8/12 NR

8/19 Br li 3051, Lans 3077, Simp 3363,
Arb. 3404

RTD 3425

5" @ 3424

DD 3427 HFW

PB 3416

18/3402-04, 16 goph, 500A

15 goph + lot wtr, sq.

8/26 NR

9/2 Spud 7-27-53

D & A

TD 3427'

8" @ 144'

Anhy 480', Heeb 2919', Br. Lime 3051,

Lans 3077, Simp 3363, Arb 3404

TD 3425'

5" @ 3424'

DD 3427 HFW PB 3416 18/ 3402-04

16 goph 500 A 15 goph co to 3416

20/ 3401-05 500 A S/ wtr.

D & A

ABANDONED

County **Rice** State **Kansas**

Sec. **22** (Blk. Twp.) **20** (Sur. Rge.) **10W** Map No.

Operator **H. S. Herbel**

Well No. **2** Farm **Kelly**

Elev.	Location	C S L NE NW

990 Ft. From N Line NW

660 Ft. From E Line Quarter

1st. Report JUL 20 1953

Completion

Remarks

Stagg Drlg. - Contr.

Spudding Date _____

Drig. Data

R U R

Kadssa

Map No. _____ Sec. 22 Twp. 20 R. 10WWell No. 2 Kelly_____H. S. Herbel_____
Company**CORRECTION**_____
Contractor

SW NE NW

SECTION PLAT

850 Ft. from N. Line

_____ Ft. from S. Line

990 Ft. from E. Line

_____ Ft. from W. Line

	o		

Rice County

Location _____

Rig up _____

Drilling and Remarks:

Reported

C S L NE NW

RECORD

Cased _____ in., _____ ft.

Sand _____

Gas _____

Oil _____

Total Depth _____

PRODUCTION

1st 24 hrs. Nat. _____

1st 24 hrs. after shot _____

Gas _____ Cu. Ft.

Dry Hole _____


Abandoned _____

Date

AUG 5 1953 19J. G. McGEHEE

Scout

County Rice State Kansas
 Sec. 22 (Blk. 20 (Sur. 10W Map No.
 (Twp.) (Rge.)
 Operator H. S. Herbel
 Well No. 2 Farm Kelly
 Elev. 1840 Location SW NE NW

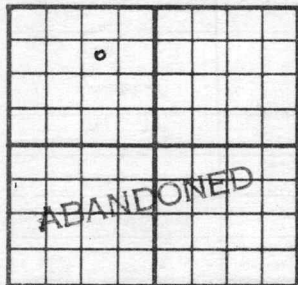

850 Ft. From N Line NW
990 Ft. From E Line Quarter
 1st. Report
 Completion SEP 2 1953
 Remarks
Stagg Drlg. - Contr.
 Spudding Date 7-27-53

Drlg. Data D & A TD 3427
8" @ 144 Anhy 480 Heeb. 2919
Br. lime 3051 Lans. 3077 Simp. 3363
Arb. 3404 TD 3425 5" @ 3424 DD 3427
HFW PB 3416 18/ 3402-04 16 goph
500 A 15 goph co to 3416 20/ 3401-05
500 A S/ wtr.

D & A

J. G. McGEHEE