


Section 25 Township 20 Range 10W

Well No. 1 Farmer

Company Lindas Oil

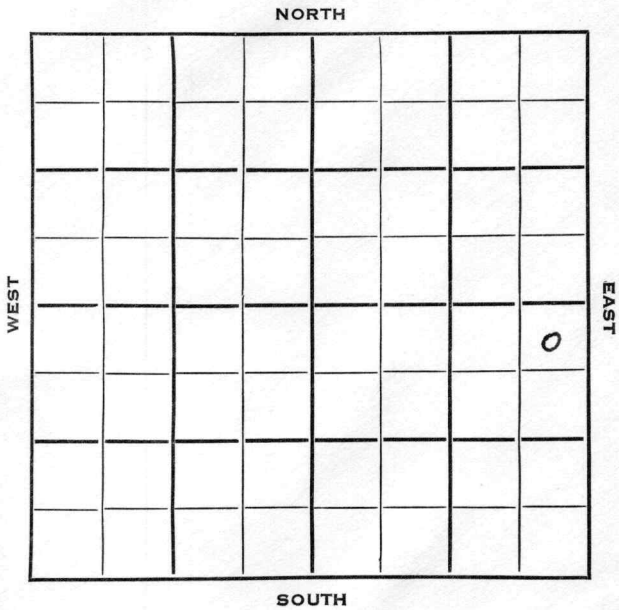

Rice

KANSAS

SEC.	TWP.	R.
25	20	10W

WELL NO.

1 Farmer

FARM

COMPANY

Lindas Oil

CONTRACTOR

Lindas
Wildcat

330

Ft. from N. Line


Ft. from S. Line

330

Ft. from E. Line

Ft. from W. Line

NE NE SE

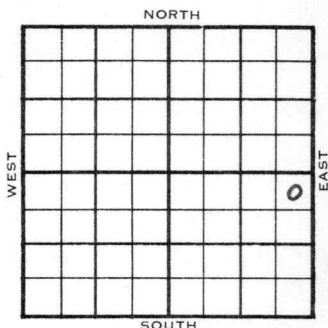

1953

ELEVATION

Elev. 1736'

REPORT

9/16

Spud 9-10-53
 8" @ 107'
 Anhy 365
 Drlg. 2281'

9/23

D & A

9/30

Spud 9-10-53 D & A TD 3370
 8" @ 107 Anhy 365 Heeb 2829
 Br. lime 2962 Lans 2989
 B KC 3270

DST 3266-3304 open $\frac{1}{2}$ hr rec 30' mud
 240#

DST 3298-3320 Simp 3308

Arb. 3352 TD 3370

D & A

ABANDONED

County Rice State Kansas

Sec. 25 (Blk. Twp.) 20 (Sur. Rge.) 10W Map No.

Operator **Lindas Oil**

Well No. **1** Farm **Farmer**

Elev.	Location	NE	NE	SE
-------	----------	----	----	----

FIRST REPORT

330 Ft. From N Line SE

330 Ft. From E Line Quarter

1st. Report SEP 16 1953

Completion

Remarks


Lindas - Contr.

Spudding Date 9-10-53

Drig. Data Wildcat

8" @ 107 Anhy 365 drlg. 2281

County Rice State Kansas
 Sec. 25 (Blk. 20) (Sur. 10W) (Rge.) Map No.
 Operator Lindas Oil
 Well No. 1 Farm Farmer
 Elev. 1736 Location NE NE SE

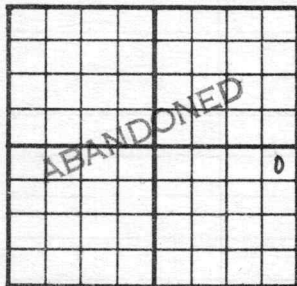

330 Ft. From N Line SE
330 Ft. From E Line Quarter
 1st. Report
 Completion SEP 30 1953
 Remarks Wildcat
Lindas - Contr.
 Spudding Date 9-10-53

Drlg. Data D & A TD 3370
8" @ 107 Anhy 365 Heeb. 2829
Br. lime 2962 Lans. 2989 B KC 3270
DST 3266-3304 open $\frac{1}{2}$ hr. Rec. 30' mud
240# DST 3298-3320 Simp. 3308
Arb. 3352 TD 3370

D & A

J. G. McGEHEE