

Rice

20

Map No. KANSAS Sec. 27 Twp. ~~27~~ R. 10^w

Well No. 1- Bill Farm

Rodgers et al Company
Lot 24 Blk 4 NORTH


_____ Ft. from N. Line

220 Ft. from S. Line

_____ Ft. from E. Line

200 Ft. from W. Line

1930

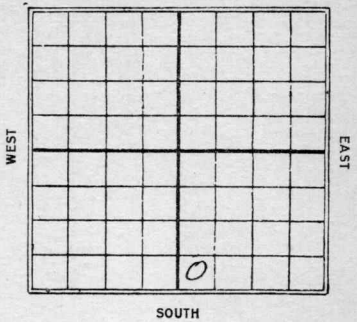

Date

REPORT

Date	REPORT
<u>4/9</u>	<u>Rig</u>
<u>4/16</u>	<u>Spud 150'</u>
<u>4/23</u>	<u>hrlg. 850'</u>
<u>4/30</u>	<u>" 1205'</u>
<u>5/7</u>	<u>" 1758' show</u> <u>gas. 1385-90</u> <u>10" - 1635'</u>
<u>5/14</u>	<u>hrlg. 1935'</u>
<u>5/22</u>	<u>" 2200, show</u> <u>oil 2195'</u>
<u>5/28</u>	<u>hrlg. 2335'</u>
<u>6/4</u>	<u>Sand 2485-2535'</u> <u>show oil 2495-2500</u> <u>N7W. 2500-35.</u> <u>T.D. 2535. U.P. 8"</u>
<u>6/11</u>	<u>hrlg. 2700'</u>
<u>6/18</u>	<u>" 2860'</u>
<u>6/25</u>	<u>" 3000'</u>
<u>7/2</u>	<u>show oil 3239-45</u> <u>5" - 3245'</u> <u>T.D. 3454 S.D.</u>

7/9 - S.D. 3254'

7/16 - HFW 3336-40

TD 3340

Dry & Abandon

Rice
 Map No. KANSAS Sec. 27 Twp. 21 R. 10 W
 Well No. 46 *Gill*

Rodgers & Dal Company
Raymond Tompkins Contractor
Lot 24 Block 4

SECTION PLAT

		0	

..... Ft. from N. Line
220 Ft. from S. Line
 Ft. from E. Line
200 Ft. from W. Line

FIRST REPORTS

Location.....
 Rig up.....
 Drilling and Remarks:

Rig

RECORD

Cased..... in., ft.
 Sand.....
 Gas.....
 Oil.....
 Total Depth.....

PRODUCTION

1st 24 hrs. Nat.....
 1st 24 hrs. after shot.....
 Gas..... Cu. Ft.
 Dry Hole.....
 Abandoned.....

Date

APR 9 - 1930 192..... S. J. LEWIS Scout

Rice

Map No. KANSAS Sec. 27 Twp. 20 R. 10W

Well No. 46 *Gill*

Rodgers & Dal Company

Raymond Tronite Contractor

Lot 24 Block 4

SECTION PLAT

..... Ft. from N. Line

220 Ft. from S. Line

..... Ft. from E. Line

200 Ft. from W. Line

CORRECTION

Location.....

Rig up.....

Drilling and Remarks:

Rig
reported in
27-21-10W

RECORD

Cased..... in., ft.

Sand.....

Gas.....

Oil.....

Total Depth.....

PRODUCTION

1st 24 hrs. Nat.....

1st 24 hrs. after shot.....

Gas..... Cu. Ft.

Dry Hole.....

Abandoned.....

Date

APR 16 1930

192

S. J. LEWIS

Scout

Map No. KANSAS Sec. 27 Twp. 20 R. 10W

Well No. 46 Gill

Rodgers & Dal. Company

Raymond Downie Contractor

20824 Block 4

SECTION PLAT

_____ Ft. from N. Line

220 Ft. from S. Line

_____ Ft. from E. Line

200 Ft. from W. Line

ABANDONED

Location _____

Rig up _____

Drilling and Remarks:

NW 3336-40

RECORD

Cased _____ in., _____ ft.

Sand _____

Gas _____

Oil _____

Total Depth 3340

PRODUCTION

1st 24 hrs. Nat. _____

1st 24 hrs. after shot _____

Gas _____ Cu. Ft.

Dry Hole _____

Abandoned _____

Date

JUL 16 1930 19

S. J. LEWIS

Scout