


Race

Map No. KANSAS Sec. 27 Twp. 20 R. 10^w

Well No. 1- Snyder Farm
Robertson et al Company

330 Ft. from N. Line
 _____ Ft. from S. Line
 _____ Ft. from E. Line
990 Ft. from W. Line
1930

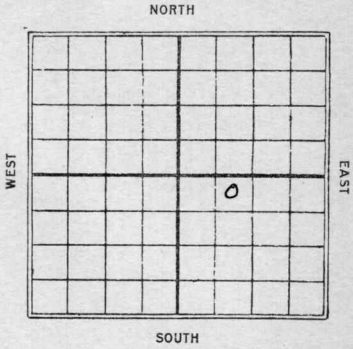

Date

REPORT

Date	REPORT
5/14	ROG.
5/21	Bldg rig
5/28	Rig up
6/4	Spud
6/11	hrlg. 1300'
6/18	" 2000'
6/25	" 2110'
7/2	" 2307'
7/9	N/R 8" - 2505'
7/16	N7W 2740'
	hrlg. 2775'
7/23	Rush 6" - 2942'
7/30	hrlg. 3265'
8/6	N7W 3404 S.D.
8/13	T.D. 3405'
	Dry & abandon

Map No. *Nice* **KANSAS** Sec. *27* Twp. *20* R. *10W*

Well No. *46 Snyder*

Robertson & Dal Company

C. Block 20 Raymond Contractor

tromite

SECTION PLAT

880 Ft. from N. Line

..... Ft. from S. Line

..... Ft. from E. Line

990 Ft. from W. Line

		o	

FIRST REPORTS

Location.....

Rig up.....

Drilling and Remarks:

ROG

RECORD

Cased.....in.,ft.

Sand.....

Gas.....

Oil.....

Total Depth.....

PRODUCTION

1st 24 hrs. Nat.....

1st 24 hrs. after shot.....

Gas.....Cu. Ft.

Dry Hole.....

Abandoned.....

Date

MAY 14 1930

192.....

S. J. LEWIS

Scout

Map No. KANSAS Sec. 27 Twp. 20 R. 10W

Well No. 46 Snyder

Robertson et al Company

Raymond Townsite Contractor

SECTION PLAT

		0	

330 Ft. from N. Line

_____ Ft. from S. Line

_____ Ft. from E. Line

990 Ft. from W. Line

ABANDONED

Location _____

Rig up _____

Drilling and Remarks:

RECORD

Cased _____ in., _____ ft.

Sand _____

Gas _____

Oil _____

Total Depth 8405

PRODUCTION

1st 24 hrs. Nat. _____

1st 24 hrs. after shot _____

Gas _____ Cu. Ft.

Dry Hole _____

Abandoned _____

Date

AUG 13 1930

S. J. LEWIS

Scout