
FORM 51

Rice KANSAS

Section 20 Township 18 Range 6W

Well No. 1 Wolf "A"

Company Derby Oil

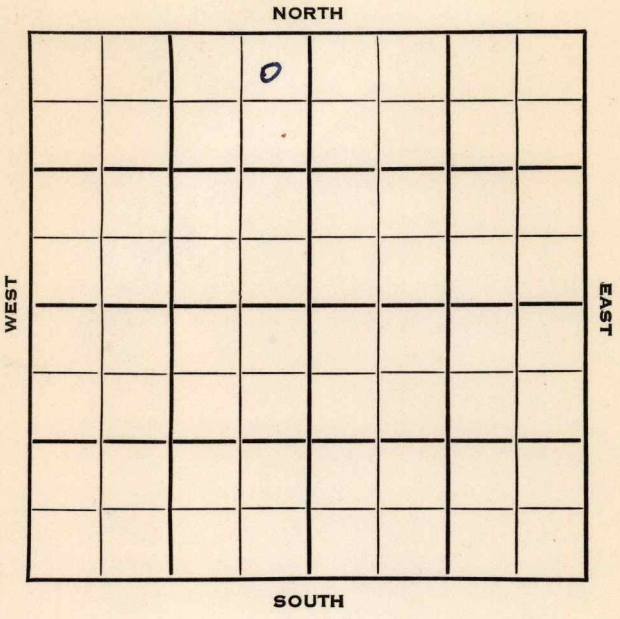

Rice KANSAS

SEC.	TWP.	R.
20	18	6W

WELL NO.

1 Wolf "A" FARM

COMPANY

Derby Oil

CONTRACTOR


330 Ft. from N. Line

Ft. from S. Line

330 Ft. from E. Line

Ft. from W. Line

NE NE NW

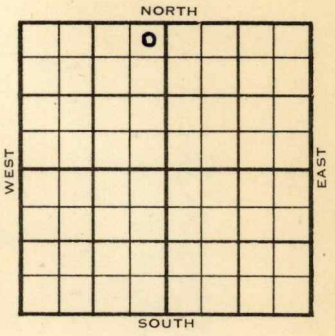

1954	ELEVATION 1689' REPORT
1/13	Location
1/20	8" @ 225' w/125 sks
1/27	Drlg. 3190'
2/3	Heeb 2628', Br li 2756', Lans 2795', B KC 3168, Cong 3273', DST 3273-80', 1 hr., 2110' gas, 180' VHly OCM, 60' free oil, 30' SW, 875# Miss 3294' RTD 3351' 5" @ 3350 KH 3336'
2/10	NR
2/17	"
2/24	"
3/3	"
3/10	"
3/17	"
3/24	"
4/14	Spud 1-18-54 Oil Well TD 3351' 8" @ 225' Heeb 2628', Br. Lime 2756', Lans 2795'

DX-78

OVER

1954

Information brought forward.

4/14 B KC 3168', Cong 3273',
DST 3273'-80' opn 1 hr, rec 2110' gas
180' vhocm 60' free oil, 30' sw
875#
Miss 3294'
TD 3341'
5" @3350'
Kh. 3336',
12/ 3275-76 30 go 17 gw 1 hr.
24/ 3273-75 13 go 16 gwph 2 hr.
frac. 11 go 15 gwph 12/ 3266-70
250 A S/ 12½ bo 28½ bw 10 hr. frac.
S/ 24 bo 41 bw 17 hr. S/ 9 bo
19 bw 8 hr. 18/ 3276-82 S/ 15 bo
18 bw 12hr.
48/ 3276-82 3 bfph 1/3 oil 2 hr.
500 A S/ 7 bo 12 bw 5 hr. frac.
S/ 21 bo 43 bw 10 hr. P/ 33 bo 35 bwpd
P/ 21 bo 46 bwpd P/ 19 bo 47 bwpd
Comp 20 bopd 45 bw.

COMPLETED

FORM 275 FOR SALE BY KANSAS BLUE PRINT CO.


County Rice State Kansas

Sec. 20 (Blk. Twp.) 18 (Sur. Rge.) 6W Map No.

Operator Derby Oil

Well No. 1 Farm Wolf "A"

Elev. Location NE NE NW

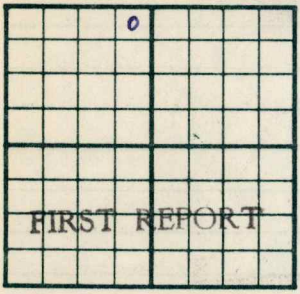

330 Ft. From N Line NW

330 Ft. From E Line Quarter

1st. Report JAN 13 1954

Completion

Remarks

Spudding Date

Drlg. Data

Location

J. G. McGEHEE

FORM 275 FOR SALE BY KANSAS BLUE PRINT CO.


County Rice State Kansas

Sec. 20 (Blk. Twp.) 18 (Sur. Rge.) 6W Map No.

Operator Derby Oil

Well No. 1 Farm Wolf "A"

Elev. 1689 Location NE NE NW

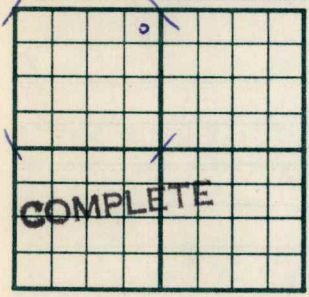

330 Ft. From N Line NW

330 Ft. From E Line Quarter

1st. Report

Completion APR 14 1954

Remarks Wildcat

Badger - Contr.

Spudding Date 1-18-54

Drlg. Data Oil well TD 3351

8" @ 225 Heeb. 2628 Br. lime 2756

Lans. 2795 B KC 3168 Cong. 3273

DST 3273-80 open 1 hr. Rec. 2110' gas

180' vhocm 60' free oil 30' sw 875#

Miss. 3294 TD 3341 5" @ 3350 Kh. 3336

12/ 3275-76 30 go 17 gw 1 hr.

24/ 3273-75 13 go 16 gwph 2 hr. frac

11 go 15 gwph 10 hr. 12/ 3266-70

250 A S/ 12½ bo 28½ bw 10 hr. frac

S/ 24 bo 41 bw 17 hr. S/ 9 bo 19 bw

8 hr. 18/ 3276-82 S/ 15 bo 18 bw 12 hr.

48/ 3276-82 3 bfph 1/3 oil 2 hr.

500 A S/ 7 bo 12 bw 5 hr. frac

S/ 21 bo 43 bw 10 hr. P/ 33 bo 35 bwpd

J. G. McGEHEE

Drlg. Data

P/ 21 bo 46 bwpd P/ 19 bo 47 bwpd

Comp. 20 bopd 45 bw

