


Section 30 Township 20 Range 10-W

Well No. 1 Hovey Yeo

Company Gulf

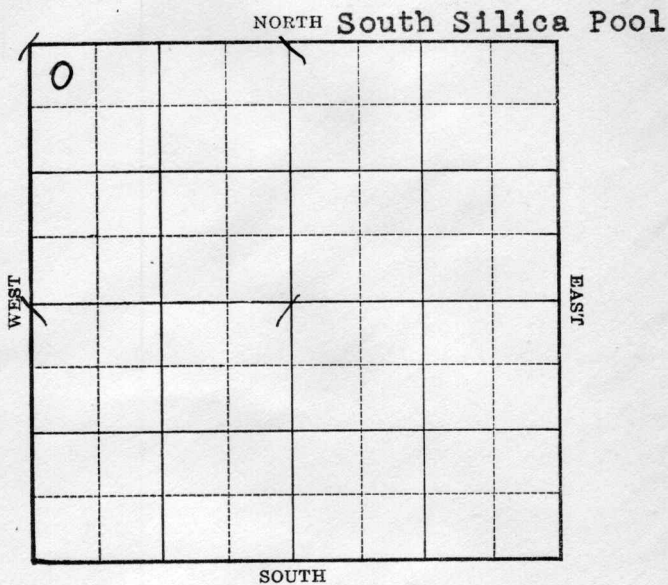

1939

4/5

7" - 3301'

Arb. 3300'

T.D. 3310'

Pump 112 oil & 89 water in 8 hrs.

Potential 337 bbls. Nat'l.

COMPLETED

Map No. _____ Sec. 30 Twp. 20 R. 10W

Well No. 1 Hovey

Gulf Company

Contractor

FIRST REPORT

NW/C

330 Ft. from N. Line


_____ Ft. from S. Line

_____ Ft. from E. Line

330 Ft. from W. Line

SOUTH SILICA POOL

SECTION PLAT

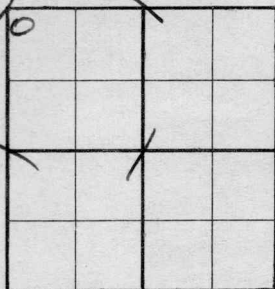

Location X

Rig up _____

Drilling and Remarks:

RECORD

Cased _____ in., _____ ft.

Sand _____

Gas _____

Oil _____

Total Depth _____

PRODUCTION

1st 24 hrs. Nat. _____

1st 24 hrs. after shot _____

Gas _____ Cu. Ft.

Dry Hole _____

Abandoned _____

Date

FEB 8 - 1939

19

H. D. Hatfield Scout

Rice KANSAS

Map No. 46 Sec. 30 Twp. 20 R. 10 ^w

Well No. 1-Yeo

Gulf Company

Contractor

CORRECTION

NW/4

SECTION PLAT

0			

330 Ft. from N. Line

_____ Ft. from S. Line

_____ Ft. from E. Line

330 Ft. from W. Line

CORRECTION

Location _____

Rig up _____

Drilling and Remarks:

*Farm Name
changed from
Hovey to Yeo*

RECORD

Cased _____ in., _____ ft.

Sand _____

Gas _____

Oil _____

Total Depth _____

PRODUCTION

1st 24 hrs. Nat. _____

1st 24 hrs. after shot _____

Gas _____ Cu. Ft.

Dry Hole _____

Abandoned _____

Date

MAR 8 - 1939

19

E. D. Hatfield

Scout

Rice

KANSAS

Map No. 46 Sec. 30 Twp. 20 R. 10W

Well No. 1 Yeo

Gulf

Company

Contractor

COMPLETED

NW/C

SECTION PLAT

0			

330 Ft. from N. Line

_____ Ft. from S. Line

_____ Ft. from E. Line

330 Ft. from W. Line

SOUTH SILICA POOL

Location _____

RECORD

Cased 7 in., 3301 ft.

Sand At 3300

Gas _____

Oil _____

Total Depth 3310

PRODUCTION

1st 24 hrs. Nat. _____

1st 24 hrs. after shot _____

Gas _____ Cu. Ft.

Dry Hole _____

Abandoned _____

Rig up _____

Drilling and Remarks:

*P-112 oil
89 wtr / 8 hrs*

Pot 337

NAT

Date

APR 5 - 1939

19

H. D. Hatfield

Scout