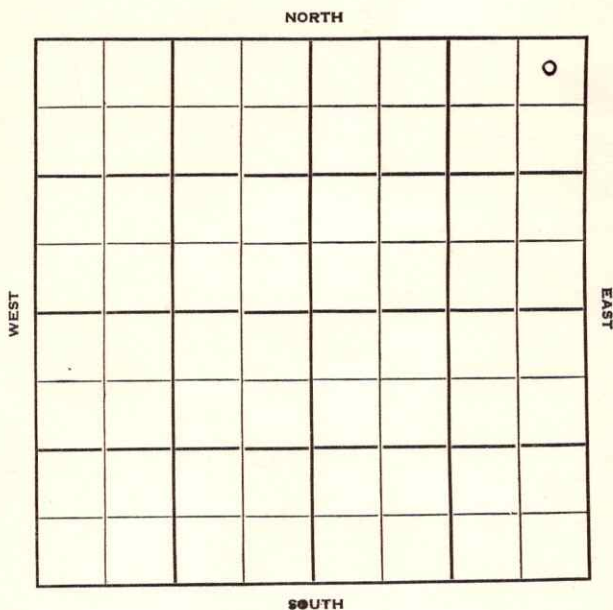


Section 35 Township 17 Range 32-WWell No. #1 Gravell (Cora Crowell)
(legs-dr 2025)Company Amerada

KANSAS

Scott

35

17

32-W

Sec. _____ Twp. _____ R. _____

#1 Cravell

(Cora Crowell)

Well No. _____ Farm _____

Amerada

Company _____

Wildcat _____ Contractor _____

330

Ft. from N. Line


Ft. from S. Line

330

Ft. from E. Line

Ft. from W. Line

NE NE NE

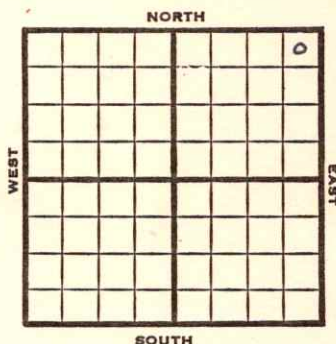

1951

Elev. 2970'

REPORT

1/10

Location

3/14

Spud 1-17-51

D&A TD 5354

8-5/8" @ 281' Her. 2746

DST 2748-70 opn 1 hr Rec. 4' mud

Krider 2791' Win. 2844'

Ft. Riley 2888'

DST 2891-2944 opn 1 hr Rec. 23' mud

Lans. 3890'

DST 3996-4030 opn 2 hr. Rec. 2450' sw

DST 4157-80 opn 2 hr Rec. 5' ocm

630' wtr Miss 4577'

DST 4737-49 opn 2 hr Rec. 900' sul wtr

St. Louis 4580 Bergen 4737

DST 4737-49 opn 2 hr Rec. 290' w r

Warsaw 4845' Osage 4955'

Kinderhook 5030 Viola 5146'

DST 5143-60 opn 2 hr Rec. 1300 sw

Arb. 5195 TD 5354 D&A

ABANDONED

County	Scott		State	Kansas	
Sec.	35	(Blk.) (Twp.)	17	(Sur.) (Rge.)	32W Map No.
Operator	Amerada				
Well No.	1	Farm	Cravell (Cora Crowell)		
Elev.	2970	Location	NE NE NE		
			330 Ft. From	N Line	NE
			330 Ft. From	E Line	Quarter
			1st. Report		
			Completion MAR 1 4 1951		
			Remarks Wildcat		
			Glenn Peel - Contr.		
			Spudding Date 1-17-51		

Drlg. Data D & A TD 5354
 8 5/8" @ 281 Her. 2746 DST 2748-70
 open 1 hr. Rec. 4' mud Krider 2791
 Win. 2844 Ft. Riley 2888 DST 2891-2944
 open 1 hr. Rec. 23' mud Lans. 3890
 DST 3996-4030 open 2 hr. Rec. 2450' sw
 DST 4157-80 open 2 hr. Rec. 5' ocm
 630' water Miss. 4577 DST 4737-49
 open 2 hr. Rec. 900' sul. water
 St. Louis 4580 Bergen 4737 DST 4737-49
 open 2 hr. Rec. 290' water Warsaw 4845
 Osage 4955 Kinderhook 5030 Viola 5146
 DST 5143-60 open 2 hr. Rec. 1300' sw
 Arb. 5195 TD 5354 D & A

J. E. TYRA

