

KANSAS

Rice


FORM 51 5M 4-41 PETROL

Section 30 Township 20 Range 10-W

Well No. #1 Yeo "B"

Company Anderson & Pritchard

NORTH Raymond Pool

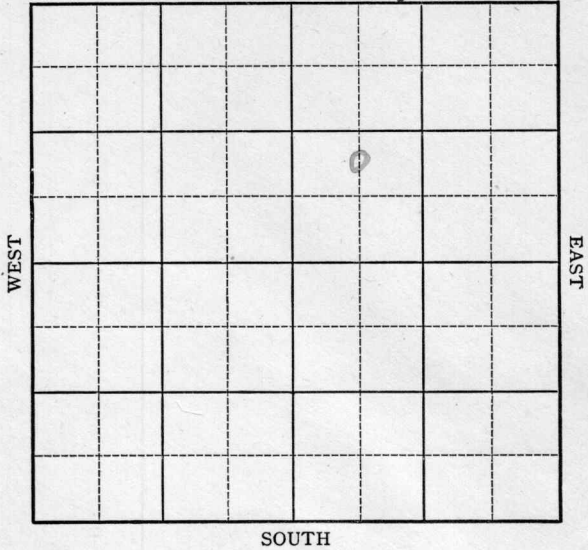

Sec. 30 Twp. 20 R. 10-W

Well No. #1 Yeo "B" Farm _____

Anderson & Pritchard Company

(Raymond)


_____ Ft. from N. Line

990 Ft. from S. Line

_____ Ft. from E. Line

660 Ft. from W. Line

Elev. 1741

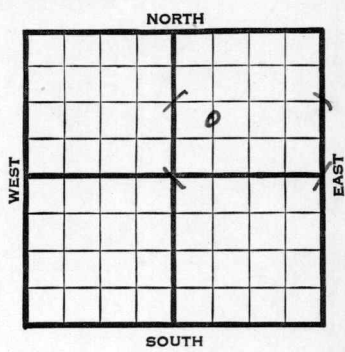

1942	REPORT
5/20	8" - 193' WOC.
5/27	Lans. 2980' Drlg. 3128' S.O.
6/3	Cong. 3294' Arb. 3311'
	5" - 3127' T.D. 3314'
	52 shots 3069-3099' 100' fluid.
6/10	" " "
6/17	Lans. 2980'
	Arb. 3311'
	5" - 3127'
	T.D. 3314'
	52 shots 3069-94'
	3000 acid.
	Pump 23 oil & 76% water.
	41.5 Gravity
	COMPLETED

Rice

Map No. 46 Sec. 30 Twp. 20 R. 10W

Well No. 1 Yeo "B"

Anderson & Pritchard Company

COMPLETED Contractor

C NL SW NE

SECTION PLAT

		o	

_____ Ft. from N. Line

990 Ft. from S. Line

_____ Ft. from E. Line

660 Ft. from W. Line

RAYMOND POOL

Location _____

Rig up _____

Drilling and Remarks:

Lease 2980
Ac + 3811
5" @ 3127
52 shot to 3069-94
3000 acid
Pump 23 oil + 76% water
41.5 gpm

RECORD

Cased _____ in., _____ ft.

Sand _____

Gas _____

Oil _____

Total Depth 3214

PRODUCTION

1st 24 hrs. Nat. _____

1st 24 hrs. after shot _____

Gas _____ Cu. Ft.

Dry Hole _____

Abandoned _____

Date

JUN 17 1942 19

S. J. LEWIS Scout