

Rice

KANSAS

6W

25

18

SECTION _____ TOWNSHIP _____ RANGE _____

WELL NO. #1 Roots

COMPANY Greenland Drlg.

NORTH

WEST

EAST

0							

SOUTH

Rice

KANSAS

SEC. 25	TWP. 18	R. 6W
------------	------------	----------

WELL NO.

#1 Roots

FARM

COMPANY

Greenland Drlg.

CONTRACTOR

Co. Tools

WILDCAT


Ft. from N. Line

Ft. from S. Line

Ft. from E. Line

Ft. from W. Line

NW NW NW

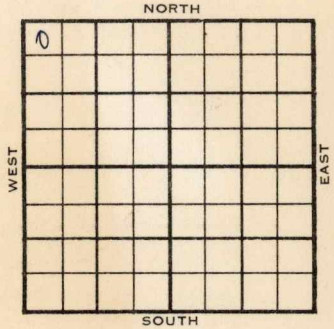

1956

ELEVATION

1675'

REPORT

4-25

Comm. 4-23-56
8" @ 155 w/120

5-9

D&A

H. 2680', Tr. 2723', Dg. sd. 2749',
 Dg. sh. 2760', BL 2830', Lsg. 2861,
 C. 3356', M. 3494',
 TD 3522'.

ABANDONED

County Rice Elev. 1675
 Sec. 25 Twp. 18 Rge. 6W
 Company Greenland Drlg.
 Farm Name Roots No. 1

TOPS	DEPTH	LOG	DATUM	Loc. in Sec.
Anh.				NW NW NW
TP.				
H.	2680			
Tr.	2723			
Dg. <u>sd</u>	2749			
Bz. <u>D95h</u>	2760			
L. <u>BL</u>	2830			Geol.
N.C. <u>L39</u>	2861			Contr.
B.K.C.				
Ce.				Co. tools
C.	3356			
M.	3494			Pool
M.				Wildcat
K.				
Mz.				
Me.				
V.				
S.				
S.				
A.				
R.				
PC.				
G.				
T.D.	3522			

ABANDONED

Date Comm. 4-23-56 MAY 9 1956
 8" @ 155/120 MAY 2 '56 3180 MAY 9 '56

D & A.

County Rice Elev. _____
 Sec. 25 Twp. 18 Rgs. 6W
 Company Greenland Drlg.
 Farm Name Roots No. 1

TOPS	DEPTH	LOG	DATUM	Loc. in Sec.
Anh.				NW NW NW
Tr.				
H.				
Tr.				
Dg.				
Bl.				
L.				Geol.
K.C.				Contr.
B.K.C.				Co. tools
Ce.				Pool
C.				Wildcat
M.				
K.				
Mz.				
Mq.				
V.				
S.				
S.				
A.				
R.				
PE.				
G.				
T.D.				

Date Comm. 4-23-56
8" @ 155/120

MAY 5 1956

R.G.