

KANSAS


FORM 51 5M 1-42 PETROL

Rice

Section 29 Township 20 Range 10W

Well No. #1 Yeo

Company Derby etal.

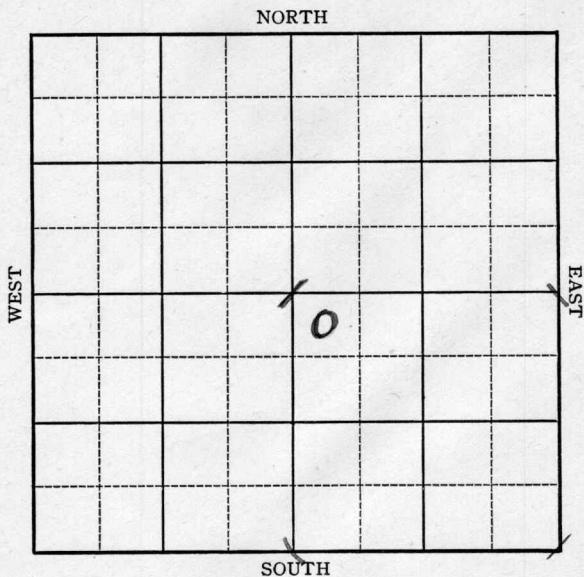

Sec. 29 Twp. 20 R. 10W

Well No. #1 Yeo Farm

Derby et al. Company


Raymond

330 Ft. from N. Line

 Ft. from S. Line

 Ft. from E. Line

330 Ft. from W. Line

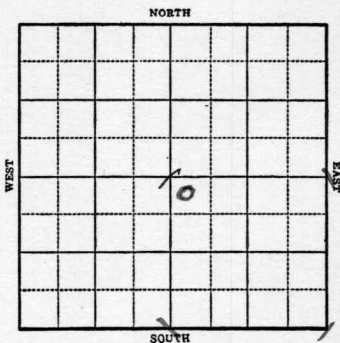

1944

R E P O R T

3/1	Location
3/8	Rotary
3/16	8" @ 225 Drilling 2555
3/22	Lans 2988 Arb. 3303 TD 3355

ABANDONED

KANSAS

Map No. 46 Sec. 29 Twp. 20 R. 10WWell No. 1 YeoDerby et al.


Company

FIRST REPORT

Contractor

NW SE

SECTION PLAT

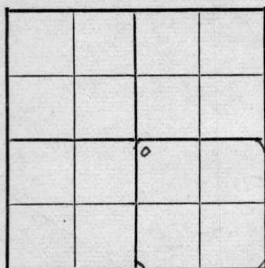330 Ft. from N. Line

Ft. from S. Line

Ft. from E. Line

330 Ft. from W. LineRaymond PoolLocation X

Rig up

Drilling and Remarks:

RECORD

Cased _____ in., _____ ft.

Sand _____

Gas _____

Oil _____

Total Depth _____

PRODUCTION

1st 24 hrs. Nat. _____

1st 24 hrs. after shot _____

Gas _____ Cu. Ft.

Dry Hole _____

Abandoned _____

Date

MAR 1 1944 19S. J. LEWIS

Scout

Map No. 46 Sec. 29 Twp. 20 R. 10W

Well No. 1 Yeo

Derby et al.

Company

ABANDONED

Contractor

NW SE

SECTION PLAT

		6	

330 Ft. from N. Line

_____ Ft. from S. Line

_____ Ft. from E. Line

330 Ft. from W. Line

Raymond Pool

Location _____

Rig up _____

Drilling and Remarks:

Loss 2988

Per Y 3349

RECORD

Cased _____ in., _____ ft.

Sand _____

Gas _____

Oil _____

Total Depth 3355

PRODUCTION

1st 24 hrs. Nat. _____

1st 24 hrs. after shot _____

Gas _____ Cu. Ft.

Dry Hole _____

Abandoned _____

Date

MAR 22 1944 19

S. J. LEWIS

Scout