

KANSAS

Rice

FORM 51 5M 10-41 PETROL

Section 33 Township 20 Range 10-W

Well No. 1 Willard Estate


Company Luther Mackall

Wildcat

NORTH

WEST

EAST

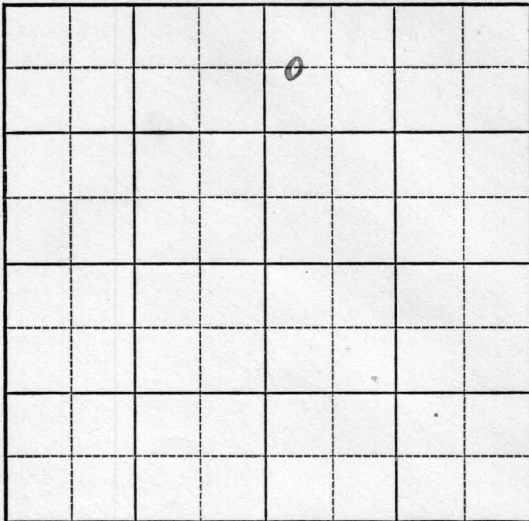

SOUTH

KANSAS

Rice

Sec. 33 Twp. 20 R. 10-W

Well No. #1 Willard Estate Farm

Luther MacKall Company

(Wildcat)


660 Ft. from N. Line

_____ Ft. from S. Line

_____ Ft. from E. Line

330 Ft. from W. Line

Elev. 1723

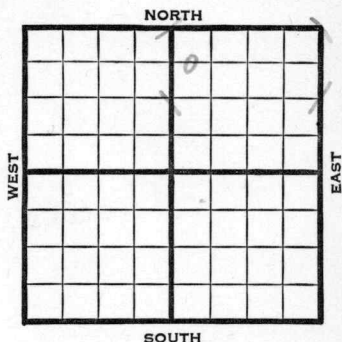

1941	REPORT
12/3	Cellar.
12/11	"
12/18	10" @ 250 Drlg. 1720
12/24	Drlg. 2720'
12/31	Lans. 2983' Arb. 3327-45' T.D.
	No shows. 5" - 3075'?
1942	
1/8	5" - 3108' P.B. to 3074'
	48 shots 3061-73½' 1500 acid.
	Swab 1½ fluid per hour, 50% wtr.
1/14	Arb. 3327'
	Lans. 2983'
	5" - 3108'
	T.D. 3347'
	48 shots 3061-73½'
	7500 acid.
	Water.
	ABANDONED

Rice

KANSAS

Map No. 46 Sec. 33 Twp. 20 R. 10WWell No. 1 Willard EstateLuther MacKall


Company

FIRST REPORT

Contractor

C $W\frac{1}{2}$ NW NE

SECTION PLAT

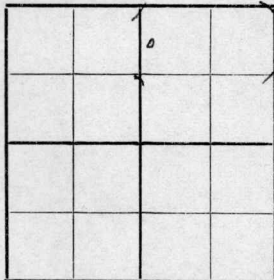660 Ft. from N. Line

Ft. from S. Line

Ft. from E. Line

330 Ft. from W. Line

WILDCAT

Location

Rig up

Drilling and Remarks:

Cellar

RECORD

Cased _____ in., _____ ft.

Sand _____

Gas _____

Oil _____

Total Depth _____

PRODUCTION

1st 24 hrs. Nat. _____

1st 24 hrs. after shot _____

Gas _____ Cu. Ft.

Dry Hole _____

Abandoned _____

Date

DEC 3 1941 19S. J. LEWIS

Scout

Rice

KANSAS

Map No. 46 Sec. 33 Twp. 20 R. 10WWell No. 1 Willard EstateLuther MacKall CompanyABANDONED ContractorC $W\frac{1}{2}$ NW NE660 Ft. from N. Line Ft. from S. Line Ft. from E. Line330 Ft. from W. Line

SECTION PLAT

		0	

WILDCAT

Location Rig up

Drilling and Remarks:

*Cu 83327**Lans 2983**5" @ 3108**48 shots to 3061-72 1/2**7500 Gravel**Water.*

RECORD

Cased in., ft.Sand Gas Oil Total Depth 3347

PRODUCTION

1st 24 hrs. Nat. 1st 24 hrs. after shot Gas Cu. Ft.Dry Hole Abandoned

Date

JAN 14 1942

19

S. J. LEWIS

Scout