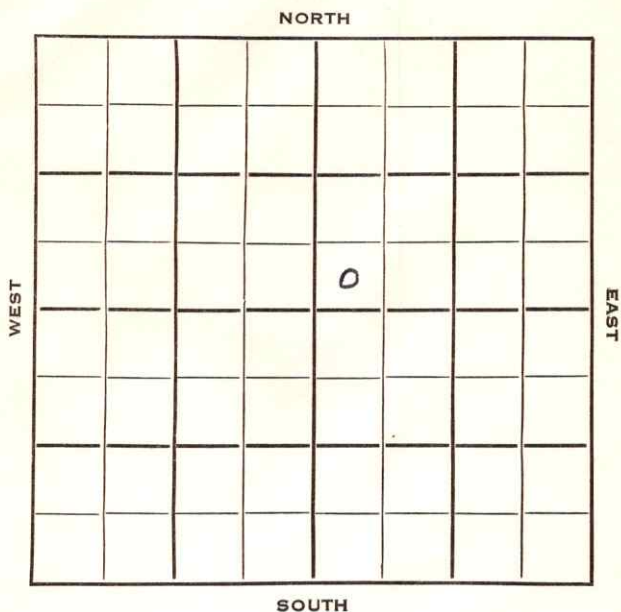


Section 11 Township 19 Range 15WWell No. 1 CampbellCompany Adkins Drlg.

Barton

KANSAS ✓

SEC.	TWP.	R.
11	19	15W

WELL NO.

1 Campbell

FARM

COMPANY

Adkins Drlg.

CONTRACTOR

Adkins Drlg.

SE Merten Pool

Ft. from N. Line


330

Ft. from S. Line

Ft. from E. Line

330

Ft. from W. Line

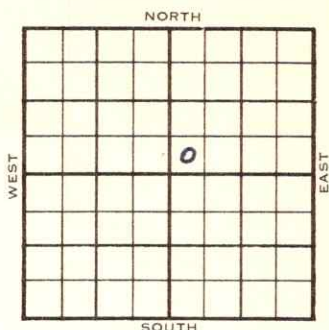

SW SW NE

1953

ELEVATION

1963'

REPORT

9/16

Spud 9-12-53

8" @ 900'

Drlg. 1045'

9/23

Anhy 928' H_{eb} 3189 Lans 3277

DST 3452-57, 1 hr, 720' gas, 30'

OCM, 330#

Drlg. 3464'

9/30

Reagan 3579'

DST 3582-3602', 2½ hrs, 152' hly

O & GCM, 110' oil, 790#

RTD 3602' 5" @ 3581' CO

10/7

CO 3602

S. 1 boph 1500 A S/ 6 boph POP

10/14

NR

10/21

NR

10/28

"

11/4

"Q

11/11

NR

11/18

"

12/9

"

OVER

County Barton State Kansas
 Sec. 11 (Blk.) 19 (Sur.) 15W Map No.
 Operator Adkins Drlg. & Frontier Oil
 Well No. 1 Farm Campbell
 Elev. 1963 Location SW SW NE



330 Ft. From S Line NE
330 Ft. From W Line Quarter
 1st. Report
 Completion DEC 30 1953
 Remarks SE Merten Pool
Adkins Drlg. - Contr.
 Spudding Date 9-12-53

Drlg. Data D & A TD 3602
8" @ 900 Anhy 928 Heeb. 3189
Lans. 3277 DST 3452-57 open 1 hr.
Rec. 720' gas 30' ocm 330# Regan 3579
DST 3582-3602 open 2½ hr. Rec. 152'
ho & gcm 110' oil 790# TD 3602
5" @ 3581 CO to 3602 S/ 1 boph
1500A S/ 6 boph PB 3599 PB 3593
SD-frac S/ wtr. sq. CO to 3592
B/ 3 go 2 gwph

D & A

J. G. McGEHEE

1953
12/16
12/30

No report

Spud 9-12-53

D. & A TD 3602' 8" @ 900

Anhy 928' Heeb 3189 Lans. 3277

DST 3452-57 open 1 hr rec 720' gas,
30' OCM 330# Regan 3579

DST 3582-3602 open 2½ hr rec 152'

HO & GCM, 110' oil 790#

TD 3602 5" @ 3581 CO to 3602

S/1 BOPH 1500 A S/6 BOPH

PB 3599 PB 3593 Sd-frac. S/wtr.

Sq. CO to 3592 B/3 GO 2 GWPH

D & A

ABANDONED