
FORM 51 10M 7-48 PETROL KANSAS Ellis

Section 26 Township 14 Range 19W

Well No. 3 (Kgs 10r) 1 Copeland

Company Trojan

Kraus Pool

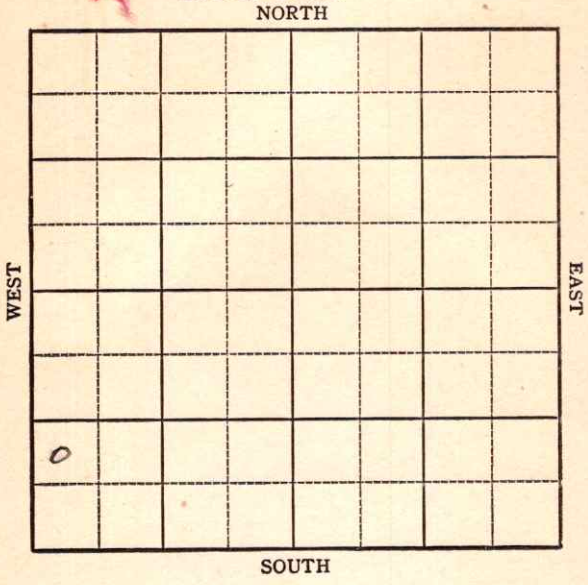

FORM 252-A
5M 10-48 PETROL

KANSAS

Ellis ✓

Sec. 26 Twp. 14 R. 19W

Well No. 3 #1 Copeland Farm

Trojan Company

Kraus Pool


Ft. from N. Line

990' Ft. from S. Line

Ft. from E. Line

330' Ft. from W. Line

NW SW SW

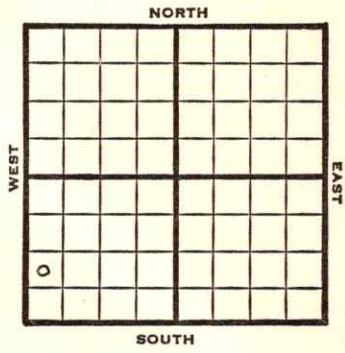

1949	REPORT
2/2	8" @ 167' Lans. 3427' Congl 3719' Gorham 3762' TD 3767' D&A FIRST REPORT ABANDONED

Form 26 200 Bks. 9-48 Petrol

Kansas

Kraus Pool

Map No. 70 Sec. 26 Twp. 14 R. 19W

Well No. 3-1 Copeland


Trojan Company

FIRST REPORT Contractor

NW SW SW

ABANDONED end El. 2096

SECTION PLAT

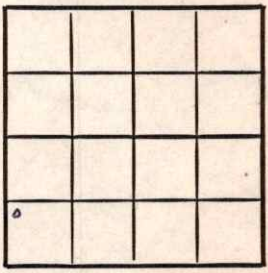

Ft. from N. Line

990 Ft. from S. Line

Ft. from E. Line

330 Ft. from W. Line

Ellis County

Location

Rig up

Drilling and Remarks:

8" @ 167

Lans. 3427

Cong. 3719

Gorham 3762

D & A

RECORD

Cased in., ft.

Sand

Gas

Oil

Total Depth 3767

PRODUCTION

1st 24 hrs. Nat.

1st 24 hrs. after shot

Gas Cu. Ft.

Dry Hole

Abandoned

Date

FEB 2 1949 19

S. J. LEWIS Scout