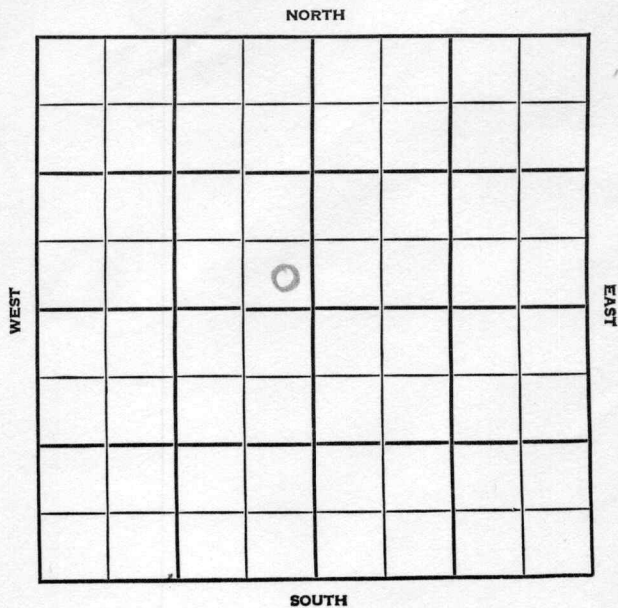


Rice

KANSAS

Section 35 Township 20 Range 10WWell No. #1 BurnsCompany Shelly-Miller

Rice

KANSAS

SEC.	TWP.	R.
35	20	10W

WELL NO.

1 Burns

FARM

COMPANY

Shelly-Miller

CONTRACTOR

Co. Tools

Wildcat

Ft. from N. Line

330'

Ft. from S. Line


330'

Ft. from E. Line

Ft. from W. Line

SE SE NW

CSO - DHM & FO

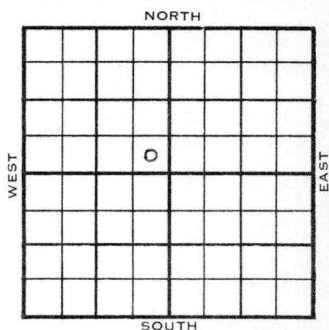

1955

ELEVATION

REPORT

5/25

Spud 5-23-55

8" @ 190

WOC

DST 3033-45 open $\frac{1}{2}$ hr. Rec. 15' mud
 0/20" DST 3049-63, open 1 hr. Rec.
 330' gas 120' O&GCM 30' gmw 750/20"
 DST 3264-85, open $\frac{1}{2}$ hr. Rec. 20'
 mud, 60# DST 3296-3315, open $\frac{1}{2}$ hr.
 Rec. 32' mud 900# D&A

Tops:	Depth	Datum
Anh	351	
H.	2809	1097
BL	2937	1225
L.	2962	1250
C. Sd.	3266	1554
S. sh.	3287	1575
S. sd.	3303	1591
A.	3350	1638
TD	3374	1662

ABANDONED

County Rice State Kansas
Sec. 35 (Blk. 20 (Sur. 10W Map No.
Twp.) Rge.)
Operator Shelly-Miller
Well No. 1 Farm Burns
Elev. Location SE SE NW



330Ft. From S Line NW
330Ft. From E Line Quarter
1st. Report MAY 25 1955
Completion _____
Remarks CST - DHM & FO
Co. tools
Spudding Date 5-23-55

Drlg. Data Wildcat
8" @ 190 WOC

K-12

County Rice Elev. 1712
Sec. 35 Twp. 20 Rge. 10W
Company Shelly-Miller
Farm Name Burns No. 1

TOPS	DEPTH	LOG	DATUM	Loc. in Sec.
Anh.	351			SE SE NW
Tp.				
H.	2809		1097	
Tr.				
Dg.				
Bl.	2937		1225	
L.	2962		1250	Geol.
K.C.				
B.K.C.				Contr.
Ce.				
C. sd	3266		1554	Co. tools
M.				
M.				Pool
K.				
Mz.				Wildcat
Mq.				
V.				
S. sh.	3287		1575	
S. sd	3303		1591	
A	3350		1638	
R.				
Pe.				
G.				
TD	3374		1662	

ABANDONED

Date Comm. 5-23-55 JUN 8 1955
8" @ 190 DST 3033-45 open $\frac{1}{2}$ hr.
Rec. 15' mud 0/20" DST 3049-63
open 1 hr. Rec. 330' gas 120' o & gcm
30' gmw 750/20" DST 3264-85 open $\frac{1}{2}$ hr
Rec. 20' mud 60# DST 3296-3315
open $\frac{1}{2}$ hr. Rec. 32' mud 900#
D & A